

MISSISSIPPI DEPARTMENT OF NATURAL RESOURCES

Bureau of Land and Water Resources

Southport Mall

P.O. Box 10631

Jackson, Mississippi 39209

CODED

WATER WELL DRILLERS LOG

LEFLORE  
F 75  
9-86

Powell Sr Leflore  
firm name county well located

date well completed

firm name

county well located

LANDOWNER:

Prudential Inc  
Memphis, Jr  
(mailing address)

description of formations encountered

description of formations encountered	from	to
Clay	0	23
fine clay + sand	23	53
Coarse sand + gravel	53	113

WELL LOCATION:

sec 20 T 20 N R 2 E  
S W  
6 miles NE of Sunflower  
(distance) (direction) (nearest town)

WELL PURPOSE:

drinking water  
(home, irrigation, municipal, industrial)

WELL COMPLETION DATA:

- (1) diameter (inches) 16
- (2) total depth (feet) 113
- (3) static water level (feet) 24 below top of ground.
- (4) casing steel, 73, (material) (depth)  
(size) if telescope see back.
- (5) screen 40, 73 (length) (depth to top)  
16, steel (size) (material)
- (6) pump 60, 2200 (HP) (yield gpm)  
Electric (type power)
- (7) electric log No (yes or no)

(organization running log)

(8) how well bottom plugged  
steel plate

DRILLERS REMARKS:

86149MG-5-05


RECEIVED

OCT 27 1986

Department of Natural Resources  
Bureau of Land & Water Resources

If well telescopes please sketch and show depths.

GROUND LEVEL

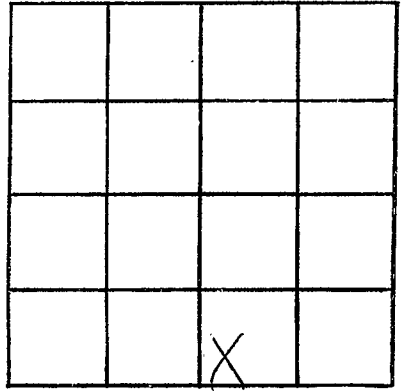

SECTION 20

Please indicate well location X.

ADDITIONAL INFORMATION

If more than one screen,  
show locations of each on sketch.