

F-80
LEFLORE
9-3-80

MISSISSIPPI
BOARD OF WATER COMMISSIONERS
416 North State Street
Jackson, Mississippi 39201

CODED

WATER WELL DRILLERS LOG

SEPT 3 1980 BUTANE GAS COMPANY OF GREENWOOD LEFLORE
date well completed county well located

LANDOWNER: William Tackett
ITA BENA, MS

description of formations encountered	from	to
CLAY	1	20
SAND	20	60
SAND & GRAVEL	60	140
CLAY	140	180
SHALE & CLAY	180	230
CLAY	230	320
SHALE	320	380
SAND	380	560
CLAY	560	720
SHALE & SAND	720	905
SAND	905	965

(mailing address)

WELL LOCATION:
sec. 3 T 20 N R 2 E
4 miles NW of ITA BENA
(distance) (direction) (nearest town)

WELL PURPOSE:
(home, irrigation, municipal, industrial)

- WELL COMPLETION DATA:
- (1) diameter (inches) 4 1/2"
 - (2) total depth (feet) 959'
 - (3) static water level (feet) Flow below top of ground.
 - (4) casing STEEL, 938'
(material) (depth)
4 1/2" if telescope see back.
(size)
 - (5) screen 20', 938'
(length) (depth to top)
2", STAINLESS
(size) (material)
 - (6) pump 1 20
(HP) (yield gpm)
ELECTRIC
(type power)
 - (7) electric log No
(yes or no)
No
(organization running log)
 - (8) how well bottom plugged BACK PRESSURE VALVE

CODED

DEPT. OF NATURAL RESOURCES
BUREAU OF LAND & WATER RESOURCES

SEP 8 - 1980
RECEIVED

DRILLERS REMARKS:


If well telescopes please sketch and show depths.

GROUND LEVEL

98' 4" GALV CASING

840' 2" GALV CASING

20' STAINLESS SCREEN

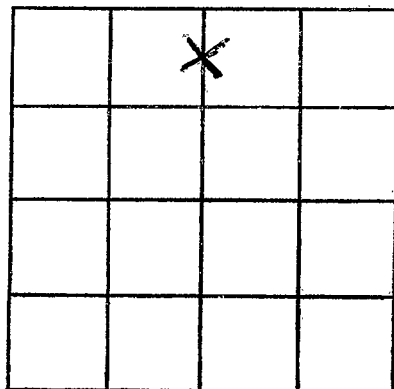

SECTION 35

Please indicate well location X.

ADDITIONAL INFORMATION

If more than one screen, show locations of each on sketch.