

MISSISSIPPI DEPARTMENT OF NATURAL RESOURCES

Bureau of Land and Water Resources

Southport Mall

P.O. Box 10631

Jackson, Mississippi 39209

WATER WELL DRILLERS LOG


CODED

Leflore
F 81
4-29-81

April 29 19 81 Larvin's well & pump Leflore
 date well completed firm name county well located

LANDOWNER: <u>Harold Coleman</u>	description of formations encountered	from	to
<u>Schultz, Miss</u> (mailing address)	<u>CLAY</u> <u>FINE SAND</u> <u>MED. & COARSE</u>	<u>0</u> <u>35</u> <u>55</u>	<u>38</u> <u>55</u> <u>114</u>
WELL LOCATION: sec. <u>33 T 20 N</u> R. <u>2 E</u> <u>5</u> miles <u>W</u> of <u>Schultz</u> (distance) (direction) (nearest town)			
WELL PURPOSE: <u>Fish Pond</u> (home, irrigation, municipal, industrial)			
WELL COMPLETION DATA:			
(1) diameter (inches) <u>16"</u>			
(2) total depth (feet) <u>114'</u>			
(3) static water level (feet) <u>21</u> below above top of ground.			
(4) casing <u>Steel</u> , <u>74'</u> (material) (depth)			
_____ if telescope see back. (size)			
(5) screen <u>40'</u> , <u>74'</u> (length) (depth to top)			
(6) pump <u>60</u> , <u>3000</u> (HP) (yield gpm)			
<u>Electric</u> (type power)			
(7) electric log <u>NO</u> (yes or no)			
_____ (organization running log)			
(8) how well bottom plugged <u>Steel</u> <u>Plate</u>			


CODED

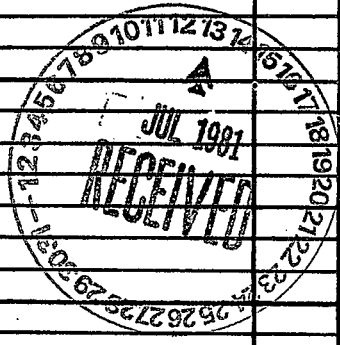

DRILLERS REMARKS:

If well telescopes please sketch and show depths.

GROUND LEVEL

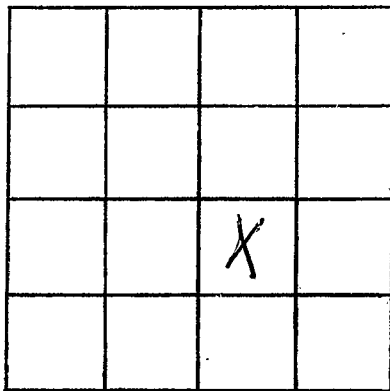

SECTION 33

Please indicate well location X.

ADDITIONAL INFORMATION

If more than one screen, show locations of each on sketch.