

MISSISSIPPI DEPARTMENT OF NATURAL RESOURCES

Bureau of Land and Water Resources

Southport Mall

P.O. Box 10631

Jackson, Mississippi 39209


WATER WELL DRILLERS LOG

CODED

*Leflore*  
 F 82  
 4-30-81

date/well completed April 30, 1981 well name Lewis well & pump county/well located Leflore

LANDOWNER: <u>William Tackett</u>	description of formations encountered		from	to
<u>Schlater, MS</u> (mailing address)	<u>CLAY</u>		<u>0</u>	<u>40</u>
	<u>FINE + MED SAND</u>		<u>40</u>	<u>60</u>
	<u>CORRE SAND</u>		<u>60</u>	<u>95</u>
<b>WELL LOCATION:</b>				
sec. <u>A T 20 N</u> R. <u>2 E</u>				
<u>6</u> miles <u>E</u> of <u>Blaine</u>				
(distance) (direction) (nearest town)				
<b>WELL PURPOSE:</b> (home, irrigation, municipal, industrial)				
<b>WELL COMPLETION DATA:</b>				
<b>CODED</b>				
(1) diameter (inches)	<u>16"</u>			
(2) total depth (feet)	<u>95'</u>			
(3) static water level (feet)	<u>26</u> below top of ground.			
(4) casing (material)	<u>Steel</u> , <u>55'</u> (depth)			
(size)	if telescope see back.			
(5) screen (length)	<u>40'</u> , <u>55'</u> (depth to top)			
(size)	<u>16"</u> , <u>Steel</u> (material)			
(6) pump (HP)	<u>1.0</u> ( <u>3000</u> yield gpm)			
(type power)				
(7) electric log (yes or no)	<u>No.</u>			
(organization running log)				
(8) how well bottom plugged	<u>Steel plate</u>			

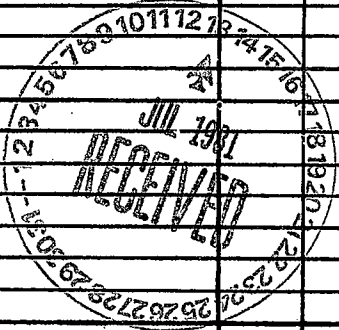

DRILLERS REMARKS:

If well telescopes please sketch and show depths.

GROUND LEVEL

X			

SECTION 11

Please indicate well location X.

ADDITIONAL INFORMATION

If more than one screen, show locations of each on sketch.