

MISSISSIPPI DEPARTMENT OF NATURAL RESOURCES

Bureau of Land and Water Resources

Southport Mall

P.O. Box 10631

Jackson, Mississippi 39209

WATER WELL DRILLERS LOG

CODED


Leflore
F 83
6-4-81

date well completed June 04 19 81 firm name Larry's well & Pump county well located Leflore

LANDOWNER: <u>William Tackett</u>	description of formations encountered	from	to
<u>Schlater, MS</u> (mailing address)			
<p>WELL LOCATION:</p> <p>sec. <u>18</u> T. <u>20</u> N. R. <u>2</u> E. W. <u>8</u></p> <p>(distance) <u>8</u> miles <u>SE</u> (direction) of <u>Schlater</u> (nearest town)</p>	<p><u>CLAY</u></p> <p><u>MED SAND</u></p> <p><u>COURSE SAND</u></p>	<p><u>0</u></p> <p><u>50</u></p> <p><u>75</u></p>	<p><u>50</u></p> <p><u>86</u></p> <p><u>116</u></p>
<p>WELL PURPOSE: <u>Fish Pond</u> (home, irrigation, municipal, industrial)</p>	CODED		
<p>WELL COMPLETION DATA:</p> <p>(1) diameter (inches) <u>16"</u></p> <p>(2) total depth (feet) <u>116'</u></p> <p>(3) static water level (feet) <u>25</u> below <u>above</u> top of ground.</p> <p>(4) casing <u>Steel</u>, <u>76'</u> (material) (depth) (size) if telescope see back.</p> <p>(5) screen <u>40'</u>, <u>76'</u> (length) (depth to top) <u>16"</u>, <u>Steel</u> (size) (material)</p> <p>(6) pump <u>60</u>, <u>3000</u> (HP) (yield gpm) (type power)</p> <p>(7) electric log <u>NO</u> (yes or no) (organization running log)</p> <p>(8) how well bottom plugged <u>Steel Plate</u></p>			
<p>DRILLERS REMARKS:</p>	<p>DEPT OF NATURAL RESOURCES BUREAU OF LAND & WATER RESOURCES</p> <p>JUL 10 1981</p> <p>RECEIVED</p>		

If well telescopes please sketch and show depths.

GROUND LEVEL

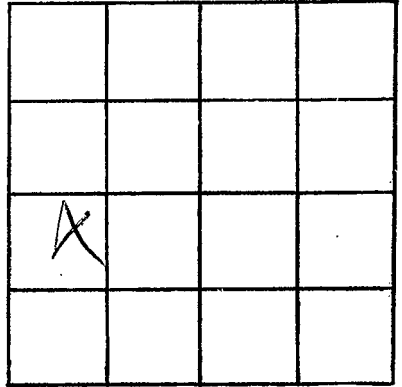

SECTION 18

Please indicate well location X.

ADDITIONAL INFORMATION

If more than one screen, show locations of each on sketch.