

MISSISSIPPI DEPARTMENT OF NATURAL RESOURCES

Bureau of Land and Water Resources

Southport Mall

P.O. Box 10631

Jackson, Mississippi 39209


WATER WELL DRILLERS LOG **CODED**

Lefflore
F 84
2-25-81



date well completed 02/25 1981 firm name Larry's Well's Pump county well located Lefflore


LANDOWNER: <u>William Tackett</u>	description of formations encountered	from	to
<u>Schlater mo</u> (mailing address)	<u>clay</u> <u>med S and</u> <u>coarse sand lignum</u>	<u>0</u> <u>20</u> <u>40</u>	<u>30</u> <u>40</u> <u>106</u>
WELL LOCATION:			
sec. <u>18</u> T <u>20</u> N R <u>2</u> W <u>10</u> miles <u>East</u> of <u>Thule</u> (distance) (direction) (nearest town)			
WELL PURPOSE: <u>Fish Pond</u> (home, irrigation, municipal, industrial)			
WELL COMPLETION DATA:			
(1) diameter (inches) <u>16"</u>			
(2) total depth (feet) <u>106'</u>			
(3) static water level (feet) <u>26</u> ^{below} / _{above} top of ground.			
(4) casing <u>Steel</u> , <u>66'</u> (material) (depth) (size) if telescope see back.			
(5) screen <u>40'</u> , <u>66'</u> (length) (depth to top)			
<u>16"</u> , <u>Steel</u> (size) (material)			
(6) pump <u>60</u> , <u>3000</u> (HP) (yield gpm)			
<u>0</u> (type power)			
(7) electric log <u>NO</u> (yes or no)			
(organization running log)			
(8) how well bottom plugged <u>Steel Plate</u>			

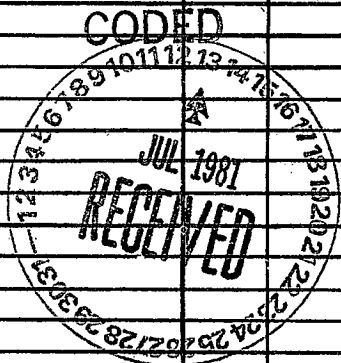

DRILLERS REMARKS:

If well telescopes please sketch and show depths.

GROUND LEVEL

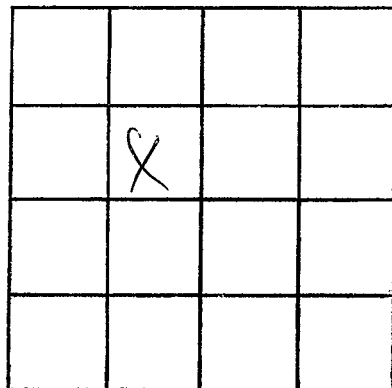

SECTION 78

Please indicate well location X.

ADDITIONAL INFORMATION

If more than one screen,
show locations of each on sketch.