

MISSISSIPPI DEPARTMENT OF NATURAL RESOURCES

Bureau of Land and Water Resources

Southport Mall

P.O. Box 10631

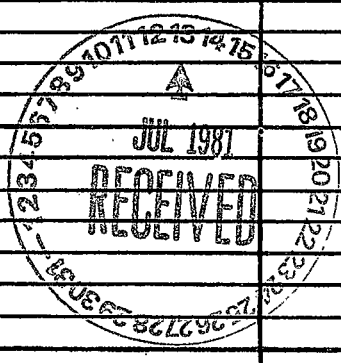
Jackson, Mississippi 39209

WATER WELL DRILLERS LOG

CODED

Leffore
F 85
4-21-81

date/well completed April 21 1981 firm name Larry's well & pump county well located Leffore

LANDOWNER: <u>William Tackett</u>	description of formations encountered	from	to
<u>Schlater, ms.</u> (mailing address)	<u>CLAY</u>	<u>0</u>	<u>60</u>
WELL LOCATION: sec. <u>19</u> T <u>20</u> N R. <u>2</u> E <u>6</u> miles <u>E</u> of <u>Blaine</u> (distance) (direction) (nearest town)	<u>FINE SAND</u>	<u>60</u>	<u>75</u>
WELL PURPOSE: <u>Fish Pond</u> (home, irrigation, municipal, industrial)	<u>COURSE SAND</u>	<u>75</u>	<u>111</u>
WELL COMPLETION DATA:	<p>CODED</p> 		
(1) diameter (inches) <u>16"</u>			
(2) total depth (feet) <u>111'</u>			
(3) static water level (feet) <u>26</u> below above top of ground.			
(4) casing <u>16"</u> <u>71'</u> (material) (depth)			
_____ if telescope see back. (size)			
(5) screen <u>40'</u> <u>71'</u> (length) (depth to top)			
_____ <u>Steel</u> (size) (material)			
(6) pump <u>60</u> <u>3000</u> (HP) (yield gpm)			
_____ (type power)			
(7) electric log <u>No</u> (yes or no)			
_____ (organization running log)			
(8) how well bottom plugged <u>Steel Plate</u>			
DRILLERS REMARKS:			

If well telescopes please sketch and show depths.

GROUND LEVEL

X			

SECTION B

Please indicate well location X.

ADDITIONAL INFORMATION

If more than one screen,
show locations of each on sketch.