

MISSISSIPPI DEPARTMENT OF NATURAL RESOURCES

Bureau of Land and Water Resources

Southport Mall

P.O. Box 10631

Jackson, Mississippi 39209 **CODED**

WATER WELL DRILLERS LOG

Leflore  
F 86  
6-15-81

6-15 19 81 BUTANE GAS COMPANY Leflore  
 date well completed OF GREENWOOD county well located

LANDOWNER:  
Magnolia Farm Service  
Chief Miler, Ms.  
 (mailing address)

description of formations encountered	from	to
<u>Hard Clay</u>	<u>0</u>	<u>23</u>
<u>SAND + soft Clay</u>	<u>23</u>	<u>34</u>
<u>SAND</u>	<u>34</u>	<u>40</u>
<u>SAND + Red GRAY</u>	<u>40</u>	<u>70</u>
<u>SAND + Gravel</u>	<u>70</u>	<u>90</u>
<u>SAND Rock</u>	<u>90</u>	<u>100</u>
<u>Clay</u>	<u>100</u>	

WELL LOCATION:  
 sec. 19 T. 20 N R. 2 E  
5.5 miles S.W. of Selfwater  
 (distance) (direction) (nearest town)

WELL PURPOSE: irrigation  
 (home, irrigation, municipal, industrial)

WELL COMPLETION DATA:

(1) diameter (inches) 16"

(2) total depth (feet) 100

(3) static water level (feet) 25 <sup>below</sup>/<sub>above</sub> top of ground.

(4) casing Steel, 60'  
 (material) (depth)  
16 if telescope see back.  
 (size)

(5) screen 40', 60'  
 (length) (depth to top)  
16", Steel  
 (size) (material)

(6) pump 60, 2500  
 (HP) (yield gpm)  
Propane  
 (type power)

(7) electric log                       
 (yes or no)  
                      
 (organization running log)

(8) how well bottom plugged Steel Plate

**CODED**

DEPT. OF NATURAL RESOURCES  
 BUREAU OF LAND & WATER RESOURCES


JUL - 2 1981

**RECEIVED**

DRILLERS REMARKS:

If well telescopes please sketch and show depths.

GROUND LEVEL

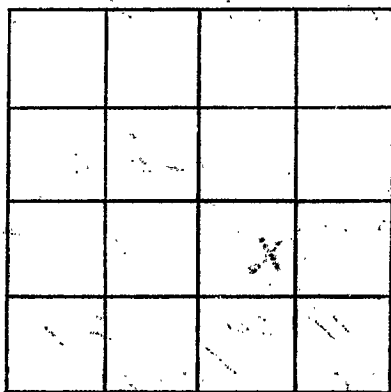

SECTION 17

Please indicate well location X.

ADDITIONAL INFORMATION

If more than one screen,  
show locations of each on sketch.