

LEFLORE
F87
3/28/83

MISSISSIPPI DEPARTMENT OF NATURAL RESOURCES
Bureau of Land and Water Resources
Southport Mall
P.O. Box 10631
Jackson, Mississippi 39209
WATER WELL DRILLERS LOG

CODED

3-28 1983 BUTANE GAS Co. Leflore
date well completed firm name county well located

LANDOWNER:	description of formations encountered	from	to
D.H. STRAIN	Clay	0	13
	SAND	15	35
(mailing address)	SAND & GRAVEL	35	110
WELL LOCATION:			
sec. <u>34 T 20 N</u> R <u>2 E</u> <u>7</u> miles <u>NW</u> of <u>Wabona</u> (distance) (direction) (nearest town)			
WELL PURPOSE: <u>IRRI.</u>			
(home, irrigation, municipal, industrial)			
WELL COMPLETION DATA:			
(1) diameter (inches) <u>16"</u>			
(2) total depth (feet) <u>110'</u>			
(3) static water level (feet) <u>30</u> <u>below</u> top of ground.			
(4) casing <u>Steel</u> , <u>70'</u> (material) (depth) <u>16"</u> if telescope see back. (size)			
(5) screen <u>24</u> , <u>70</u> (length) (depth to top)			
<u>16"</u> , <u>Steel</u> (size) (material)			
(6) pump <u>60</u> <u>2500</u> (HP) (yield gpm) <u>Electric</u> (type power)			
(7) electric log <u>No</u> (yes or no) <u>No</u> (organization running log)			
(8) how well bottom plugged <u>Steel plate</u>			
DRILLERS REMARKS: <u>Carlos Ramos</u>			


DEPT. OF NATURAL RESOURCES
BUREAU OF LAND & WATER RESOURCES

MAR 29 1983

RECEIVED

If well telescopes please sketch and show depths.

GROUND LEVEL

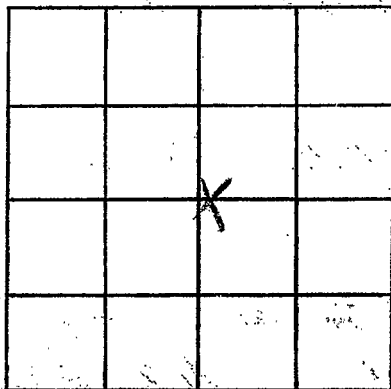

SECTION 34

Please indicate well location X.

ADDITIONAL INFORMATION

If more than one screen, show locations of each on sketch.