

MISSISSIPPI DEPARTMENT OF NATURAL RESOURCES  
Bureau of Land and Water Resources

Southport Mall  
P.O. Box 10631 **CODED**

Jackson, Mississippi 39209

**BUTAN WATER DIVISION OF GREENWOOD**  
**WATER WELL DRILLERS LOG**

POST OFFICE BOX 1135

GREENWOOD, MISS. 38930

Leflore  
F 90

5-5 1982 Leflore  
date well completed firm name county well located

LANDOWNER:	description of formations encountered	from	to
<u>Miller Bush</u>			
	<u>sand</u>	<u>18</u>	<u>40</u>
(mailing address)	<u>sand &amp; gravel</u>	<u>40</u>	<u>95</u>

**WELL LOCATION:**  
sec. 7 T. 20 N. R. 1 E. (W)  
2.25 miles S of Schlater  
(distance) (direction) (nearest town)

**WELL PURPOSE:** irrigation  
(home, irrigation, municipal, industrial)

- WELL COMPLETION DATA:**
- (1) diameter (inches) 12"
  - (2) total depth (feet) 95
  - (3) static water level (feet) 12 below above top of ground.
  - (4) casing steel, 55'  
(material) (depth)  
12" if telescope see back.  
(size)
  - (5) screen 40', 55  
(length) (depth to top)  
12", steel  
(size) (material)
  - (6) pump 40, 1500  
(HP) (yield gpm)  
Diaphragm  
(type power)
  - (7) electric log No  
(yes or no)  
No  
(organization running log)
  - (8) how well bottom plugged steel plate

**DRILLERS REMARKS:**  
Carlos Ramos


DEPT. OF NATURAL RESOURCES  
BUREAU OF LAND & WATER RESOURCES

MAY 10 1982

**RECEIVED**

If well telescopes please sketch and show depths.

GROUND LEVEL

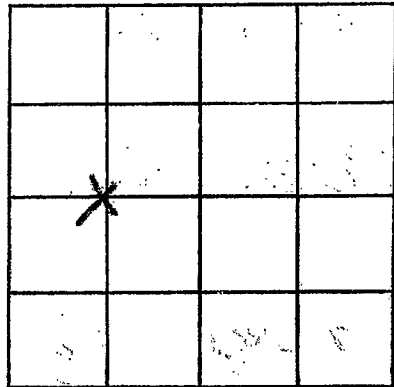

SECTION 7

Please indicate well location X.

ADDITIONAL INFORMATION

If more than one screen,  
show locations of each on sketch.