

MISSISSIPPI DEPARTMENT OF NATURAL RESOURCES

Bureau of Land and Water Resources

Southport Mall

P.O. Box 10631

Jackson, Mississippi 39209 **CODED**

WATER WELL DRILLERS LOG

*John Bratten*  
*Leflore*  
*F 411*

4/26 1982 *Myerwell & Sons Inc* *Leflore*  
 date well completed firm name county well located

LANDOWNER: *John Bratten*

description of formations encountered	from	to
<i>Clay</i>	<i>0</i>	<i>27</i>
<i>Shin sand</i>	<i>27</i>	<i>37</i>
<i>Sand</i>	<i>37</i>	<i>48</i>
<i>Sand &amp; gravel</i>	<i>48</i>	<i>108</i>

(mailing address)

WELL LOCATION:

*13* sec. *13* T *20* N R *2* E *W*  
*0.6* miles *NW* of *JITA BENA*  
 (distance) (direction) (nearest town)

WELL PURPOSE:  
 (home, irrigation, municipal, industrial)

WELL COMPLETION DATA:

- (1) diameter (inches) 16
- (2) total depth (feet) 108
- (3) static water level (feet) 18 below above top of ground.
- (4) casing STEEL, 68, (material) (depth)  
 \_\_\_\_\_ if telescope see back.  
 (size)
- (5) screen 40 68 (length) (depth to top)  
16 STEEL (size) (material)
- (6) pump 60 3000 (HP) (yield gpm)  
Desoe (type power)
- (7) electric log NO (yes or no)  
NONE (organization running log)
- (8) how well bottom plugged Plugs

DEPT. OF NATURAL RESOURCES  
 BUREAU OF LAND & WATER RESOURCES


MAY 14 1982

RECEIVED

DRILLERS REMARKS:

If well telescopes please sketch and show depths.

GROUND LEVEL

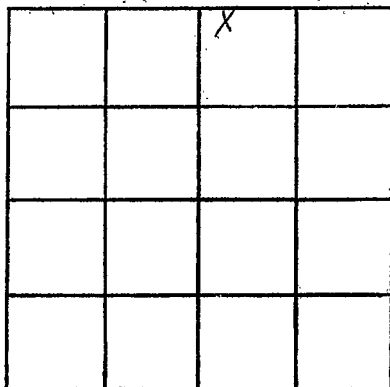

SECTION 13

Please indicate well location X.

ADDITIONAL INFORMATION

If more than one screen,  
show locations of each on sketch.