

MISSISSIPPI DEPARTMENT OF NATURAL RESOURCES

Bureau of Land and Water Resources

Southport Mall

P.O. Box 10631

Jackson, Mississippi 39209

WATER WELL DRILLERS LOG

CODED

Lefflore
F 92

2-19 1982
date well completed

Syer Well
firm name

Lefflore
county well located

LANDOWNER: Thelma & Turner

description of formations encountered	from	to
<u>Clay</u>	<u>0</u>	<u>28</u>
<u>fine sand</u>	<u>28</u>	<u>31</u>
<u>sand</u>	<u>31</u>	<u>76</u>
<u>dark brown</u>	<u>76</u>	<u>100</u>

(mailing address)

WELL LOCATION:

sec. 23 T. 20 N. R. 2 E
S 3 W
3 miles South of Schlatch
(distance) (direction) (nearest town)

WELL PURPOSE:
(home, irrigation, municipal, industrial)

WELL COMPLETION DATA:

- (1) diameter (inches) 16"
- (2) total depth (feet) 104
- (3) static water level (feet) 18 below above top of ground.
- (4) casing Steel, 63,
(material) (depth)
16"
(size) if telescope see back.
- (5) screen 40', 63
(length) (depth to top)
16", Mild Steel
(size) (material)
- (6) pump 60, 3000
(HP) (yield gpm)
Diesel
(type power)
- (7) electric log No
(yes or no)
NONE
(organization running log)
- (8) how well bottom plugged Plate

DEPT. OF NATURAL RESOURCES
BUREAU OF LAND & WATER RESOURCES


MAY 14 1982

RECEIVED

DRILLERS REMARKS:

If well telescopes please sketch and show depths.

GROUND LEVEL

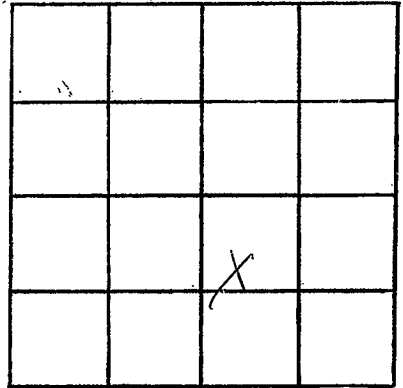

SECTION 23

Please indicate well location X.

ADDITIONAL INFORMATION

If more than one screen,
show locations of each on sketch.