

MISSISSIPPI DEPARTMENT OF NATURAL RESOURCES

Bureau of Land and Water Resources

Southport Mall

P.O. Box 10631

Jackson, Mississippi 39209

WATER WELL DRILLERS LOG

CODED

Leflore  
F 93

2-15 1982  
date well completed

Oyer Well  
firm name

Leflore  
county well located

LANDOWNER: Riverbend Plantation  
Watson Pillow  
(mailing address)

description of formations encountered	from	to
<del>CLAY</del>	0	34
<del>SAND</del>	36	48
FINE SAND		
SAND TOTAL	48	113

WELL LOCATION:  
sec. 3 T. 20 N. R. 2 E.  
4 miles SW of Schlater  
(distance) (direction) (nearest town)

WELL PURPOSE: Irrigation  
(home, irrigation, municipal, industrial)

- WELL COMPLETION DATA:
- (1) diameter (inches) 16
  - (2) total depth (feet) 113
  - (3) static water level (feet) 19 below above top of ground.
  - (4) casing Steel 73  
(material) (depth)
  - 16 If telescope see back.  
(size)
  - (5) screen 40' 40  
(length) (depth to top)
  - 16 Mild steel  
(size) (material)
  - (6) pump 40 1500  
(HP) (yield gpm)
  - Propane  
(type power)
  - (7) electric log No  
(yes or no)
  - NONE  
(organization running log)
  - (8) how well bottom plugged Plate

DRILLERS REMARKS:


DEPT. OF NATURAL RESOURCES  
BUREAU OF LAND & WATER RESOURCES

MAY 14 1982

RECEIVED

If well telescopes please sketch and show depths.

GROUND LEVEL

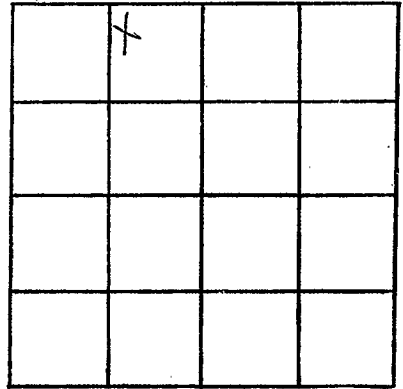

SECTION 3

Please indicate well location X.

ADDITIONAL INFORMATION

If more than one screen,  
show locations of each on sketch.