

MISSISSIPPI DEPARTMENT OF NATURAL RESOURCES

Bureau of Land and Water Resources

Southport Mall

P.O. Box 10631

Jackson, Mississippi 39209

WATER WELL DRILLERS LOG

CODED

Leflore
F 94

3/25 191982 Deep well Leflore
date well completed firm name county well located

LANDOWNER: <u>Watson Pillow</u>	description of formations encountered	from	to
(mailing address)			
WELL LOCATION: sec. <u>3</u> T <u>20</u> N S R <u>2</u> E W <u>4</u> miles <u>S-W</u> of <u>SCHLATER</u> (distance) (direction) (nearest town)	<u>Clay</u>	<u>0</u>	<u>13</u>
WELL PURPOSE: (home, irrigation, municipal, industrial)	<u>Clay</u>	<u>13</u>	<u>23</u>
WELL COMPLETION DATA: (1) diameter (inches) <u>10</u>	<u>Clay</u>	<u>23</u>	<u>33</u>
(2) total depth (feet) <u>86</u>	<u>C Sand</u>	<u>33</u>	<u>43</u>
(3) static water level (feet) <u>13</u> below above top of ground.	<u>C Sand</u>	<u>43</u>	<u>53</u>
(4) casing <u>Steel</u> (material), (depth) _____ <u>10</u> if telescope see back. (size)	<u>Sand & Gravel</u>	<u>53</u>	<u>63</u>
(5) screen <u>40</u> (length), (depth to top) _____ <u>10</u> <u>Mild Steel</u> (size) (material)	<u>Sand & Gravel</u>	<u>63</u>	<u>73</u>
(6) pump <u>30</u> (HP), <u>1000</u> (yield gpm) (type power) _____	<u>Sand & Gravel</u>	<u>73</u>	<u>83</u>
(7) electric log <u>No</u> (yes or no) (organization running log) _____	<u>Sand & Gravel</u>	<u>83</u>	<u>86</u>
(8) how well bottom plugged <u>Plate</u>			
DRILLERS REMARKS:			


DEPT. OF NATURAL RESOURCES
BUREAU OF LAND & WATER RESOURCES

MAY 14 1982

RECEIVED

If well telescopes please sketch and show depths.

GROUND LEVEL

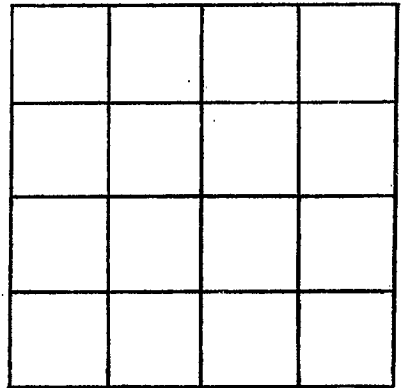

SECTION _____

Please indicate well location X.

ADDITIONAL INFORMATION

If more than one screen,
show locations of each on sketch.