

Leflore
F 95

MISSISSIPPI DEPARTMENT OF NATURAL RESOURCES
Bureau of Land and Water Resources
Southport Mall
P.O. Box 10631
Jackson, Mississippi 39209 CODED
WATER WELL DRILLERS LOG

3-25-82 Oyer Well Leflore
date well completed firm name county well located

LANDOWNER: Watson Pillard

(mailing address)
WELL LOCATION:
sec. 3 T. 20 N. R. L E.
4 miles SW of SCALATER
(distance) (direction) (nearest town)

description of formations encountered	from	to
<u>Clay</u>	<u>0</u>	<u>13</u>
<u>Clay</u>	<u>13</u>	<u>23</u>
<u>Clay</u>	<u>23</u>	<u>33</u>
<u>Sand</u>	<u>33</u>	<u>43</u>
<u>Sand</u>	<u>43</u>	<u>53</u>
<u>C Sand</u>	<u>53</u>	<u>63</u>
<u>C Sand</u>	<u>63</u>	<u>73</u>
<u>Sand & Gravel</u>	<u>73</u>	<u>83</u>
<u>Sand & Gravel</u>	<u>83</u>	<u>93</u>
<u>Sand & Gravel</u>	<u>93</u>	<u>103</u>
<u>Sand & Gravel</u>	<u>103</u>	<u>113</u>

WELL PURPOSE:
(home, irrigation, municipal, industrial)

WELL COMPLETION DATA:

- (1) diameter (inches) 16"
- (2) total depth (feet) 113
- (3) static water level (feet) 15 below above top of ground.
- (4) casing Steel (material), (depth), 16" (size) if telescope see back.
- (5) screen 40 (length), (depth to top) 16" (size), Mild Steel (material)
- (6) pump 30 (HP), 1000 (yield gpm)
(type power)
- (7) electric log No (yes or no)
(organization running log)
- (8) how well bottom plugged Plate

DRILLERS REMARKS:


DEPT. OF NATURAL RESOURCES
BUREAU OF LAND & WATER RESOURCES

MAY 14 1982

RECEIVED

If well telescopes please sketch and show depths.

GROUND LEVEL

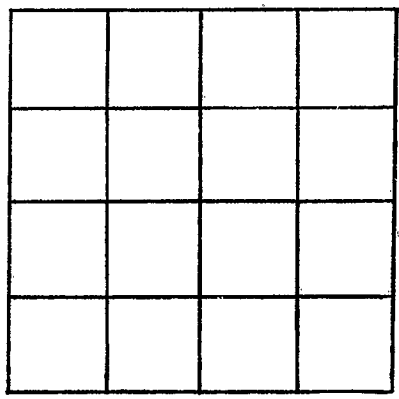

SECTION _____

Please indicate well location X.

ADDITIONAL INFORMATION

A series of horizontal lines providing space for additional information.

If more than one screen, show locations of each on sketch.