

MISSISSIPPI DEPARTMENT OF NATURAL RESOURCES

Bureau of Land and Water Resources

Southport Mall

P.O. Box 10631

Jackson, Mississippi 39209

WATER WELL DRILLERS LOG

CODED

Leflore  
F 97

4/27 19 82 Lamy's well pump Leflore  
date well completed firm name county well located

LANDOWNER: <u>Greenwood Singletary</u>	description of formations encountered	from	to
<u>Greenwood, ms</u> (mailing address)	<u>clay</u>	0	30
WELL LOCATION: sec. <u>11</u> T <u>20</u> N R <u>—</u> E S <u>—</u> W <u>2</u>	<u>metal S</u>	30	50
<u>1W</u> miles <u>1 1/2 S</u> of <u>Leblaux</u> (distance) (direction) (nearest town)	<u>course S of gravel</u>	50	103
WELL PURPOSE: (home, irrigation, municipal, industrial)			
WELL COMPLETION DATA:			
(1) diameter (inches) <u>16"</u>			
(2) total depth (feet) <u>103'</u>			
(3) static water level (feet) <u>25</u> below top of ground.			
(4) casing <u>Steel</u> , <u>63'</u> (material) (depth)			
(size) if telescope see back.			
(5) screen <u>40</u> , <u>63'</u> (length) (depth to top)			
<u>16"</u> , <u>Steel</u> (size) (material)			
(6) pump <u>60</u> <u>1200</u> (HP) (yield gpm)			
(type power)			
(7) electric log <u>No</u> (yes or no)			
(organization running log)			
(8) how well bottom plugged <u>Steel</u> <u>Plate</u>			
DRILLERS REMARKS:			


DEPT. OF NATURAL RESOURCES  
BUREAU OF LAND & WATER RESOURCES

SEP 15 1982

RECEIVED

If well telescopes please sketch and show depths.

GROUND LEVEL

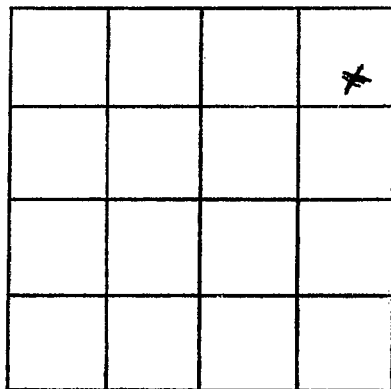

SECTION 11

Please indicate well location X.

ADDITIONAL INFORMATION

If more than one screen,  
show locations of each on sketch.