

MISSISSIPPI DEPARTMENT OF NATURAL RESOURCES

Bureau of Land and Water Resources

Southport Mall

P.O. Box 10631

Jackson, Mississippi 39209

WATER WELL DRILLERS LOG

CODED

Lefflore
F101

04/28 1982
date well completed

Lefflore
firm name


Lefflore
county well located

LANDOWNER: <u>Greenwood Irrigator</u>	description of formations encountered	from	to
<u>Greenwood, Ms.</u> (mailing address)	<u>slay</u> <u>met c</u> <u>corner of ground</u>	<u>0</u> <u>26</u> <u>50</u>	<u>20</u> <u>50</u> <u>102</u>
WELL LOCATION: sec. <u>11</u> T. <u>20</u> N. R. <u>2</u> E S. <u>2</u> W <u>1/4</u> miles <u>1 1/2</u> S of <u>Shelton</u> (distance) (direction) (nearest town)			
WELL PURPOSE: (home, irrigation, municipal, industrial)			
WELL COMPLETION DATA:			
(1) diameter (inches) <u>16"</u>			
(2) total depth (feet) <u>102'</u>			
(3) static water level (feet) <u>24</u> below above top of ground.			
(4) casing <u>Steel</u> , <u>62'</u> (material) (depth) (size) if telescope see back.			
(5) screen <u>40</u> , <u>62'</u> (length) (depth to top) <u>16"</u> , <u>steel</u> (size) (material)			
(6) pump <u>60</u> , <u>1200</u> (HP) (yield gpm) (type power)			
(7) electric log <u>N/O</u> (yes or no) (organization running log)			
(8) how well bottom plugged <u>Steel plate</u>			
DRILLERS REMARKS:			

DEPT. OF NATURAL RESOURCES
BUREAU OF LAND & WATER RESOURCES
SEP 15 1982
RECEIVED

If well telescopes please sketch and show depths.

GROUND LEVEL

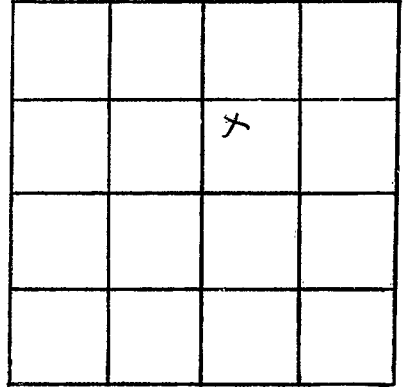

SECTION 11

Please indicate well location X.

ADDITIONAL INFORMATION

If more than one screen, show locations of each on sketch.