

LEFLORE
 F.103
 6-30-83

MISSISSIPPI DEPARTMENT OF NATURAL RESOURCES
 Bureau of Land and Water Resources
 Southport Mall
 P.O. Box 10631
 Jackson, Mississippi 39209
 WATER WELL DRILLERS LOG

CODED

June 30 19 83 BUTANE GAS CO. OF GREENWOOD Leflore
 date well completed firm name county well located

LANDOWNER:
 Tip Top Farms
 Allabena Ms.
 (mailing address)

description of formations encountered	from	to
clay	0	15
Sand	15	30
SAND & gravel	30	95

WELL LOCATION:
 sec. 32 T 19 N R 2 E
 S W
 8.5 miles N.W. of Allabena
 (distance) (direction) (nearest town)

WELL PURPOSE:
 (home, irrigation, municipal, industrial)

CODED

- WELL COMPLETION DATA:
- (1) diameter (inches) 16"
 - (2) total depth (feet) 95
 - (3) static water level (feet) 28 below top of ground.
 - (4) casing Steel, 55' (material), (depth)
 16" (size) if telescope see back.
 - (5) screen 40' 55' (length), (depth to top)
 16, steel (size), (material)
 - (6) pump 60 2500 (HP), (yield gpm)
 Diesel (type power)
 - (7) electric log No (yes or no)
 No (organization running log)
 - (8) how well bottom plugged steel plate

DEPT. OF NATURAL RESOURCES
 BUREAU OF LAND & WATER RESOURCES


JUL 19 1983

RECEIVED

DRILLERS REMARKS:
 Carlos Ramos

If well telescopes please sketch and show depths.

GROUND LEVEL

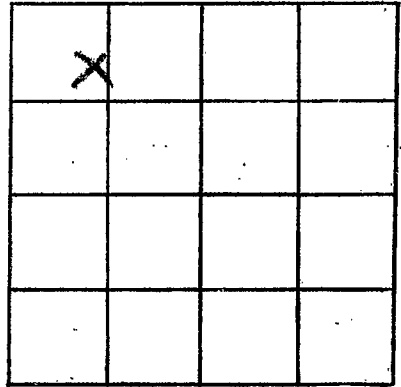

SECTION 32

Please indicate well location X.

ADDITIONAL INFORMATION

If more than one screen, show locations of each on sketch.