

MISSISSIPPI DEPARTMENT OF NATURAL RESOURCES

Bureau of Land and Water Resources

Southport Mall

P.O. Box 10631

Jackson, Mississippi 39209

WATER WELL DRILLERS LOG

BUTANE GAS COMPANY

OFFICE IN GREENWOOD

LeFlore county well located

F10A
LeFlore Co.
3-19-84

3-19 1984
date well completed

LANDOWNER: Lake Henry Pkt.
Attahena
(mailing address)

WELL LOCATION:
sec. 36 T. 20 N. R. 2 E. S. 8
4 miles N.W. of Attahena
(distance) (direction) (nearest town)

WELL PURPOSE: Domestic
(home, irrigation, municipal, industrial)

WELL COMPLETION DATA:

- (1) diameter (inches) 4" x 2"
- (2) total depth (feet) 1263
- (3) static water level (feet) 4 ^{below} top of ground.
- (4) casing Steel 960' - 2"
(material) (depth)
4"
2" if telescope see back.
(size)
- (5) screen 30' 1065
(length) (depth to top)
2" Steel
(size) (material)
- (6) pump 1.5 30 gpm
(HP) (yield gpm)
Electric
(type power)
- (7) electric log NO
(yes or no)
NO
(organization running log)
- (8) how well bottom plugged back with valve

description of formations encountered	from	to
CLAY	0	25
SAND	25	53
gravel	53	140
Thin clay rock st.	140	155
CLAY	155	180
SAND clay	180	220
SAND	220	343
HARD shale	343	383
SAND shale	383	460
shales	460	480
Hard, gamma shale	480	505
shale, red st.	505	640
shale	640	663
SAND shale	663	685
shale rocks	685	770
Hard shale	770	960
Rock shale	960	980
Hard shale	980	1020
SAND shale	1020	1040
Fine SAND	1040	1095
Hard shale	1095	1173
white clay-SAND	1173	1263

CODED

DEPT. OF NATURAL RESOURCES
BUREAU OF LAND & WATER RESOURCES


APR 23 1984

RECEIVED

DRILLERS REMARKS:
Richard Vest

If well telescopes please sketch and show depths.

GROUND LEVEL

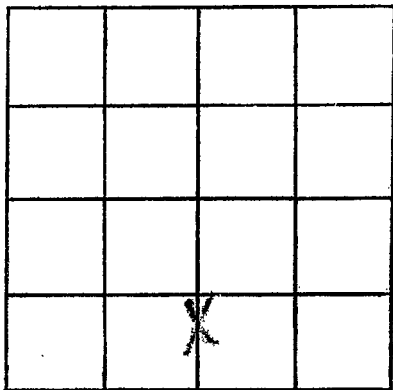

SECTION 36

Please indicate well location X.

ADDITIONAL INFORMATION

If more than one screen,
show locations of each on sketch.