

MISSISSIPPI DEPARTMENT OF NATURAL RESOURCES

Bureau of Land and Water Resources

Southport Mall

P.O. Box 10631

Jackson, Mississippi 39209

WATER WELL DRILLERS LOG

P105
Leflore Co.
3-30-84

CODED

3/30/84 19 J&K Irrigation Leflore  
 date well completed firm name county well located

LANDOWNER: Watson Pillow  
Schlater  
 (mailing address)

description of formations encountered	from	to
<u>CLAY</u>	<u>0</u>	<u>38</u>
<u>SAND Grav</u>	<u>38</u>	<u>103</u>

WELL LOCATION:  
 sec. 14 T. 200 N. R. 2 E.  
5 miles SW of Schlater  
 (distance) (direction) (nearest town)

WELL PURPOSE: IRRIGATION  
 (home, irrigation, municipal, industrial)

CODED

WELL COMPLETION DATA:

(1) diameter (inches) 16"

(2) total depth (feet) 103

(3) static water level (feet) 31 below above top of ground.

(4) casing steel, 163',  
 (material) (depth)  
16 if telescope see back.  
 (size)

(5) screen 40, 63  
 (length) (depth to top)  
16, steel  
 (size) (material)

(6) pump 40 2000  
 (HP) (yield gpm)  
Diesel  
 (type power)

(7) electric log NO  
 (yes or no)  
 (organization running log)

(8) how well bottom plugged plate

DEPT. OF NATURAL RESOURCES  
 BUREAU OF LAND & WATER RESOURCES


APR 18 1984

RECEIVED

DRILLERS REMARKS:

If well telescopes please sketch and show depths.

GROUND LEVEL

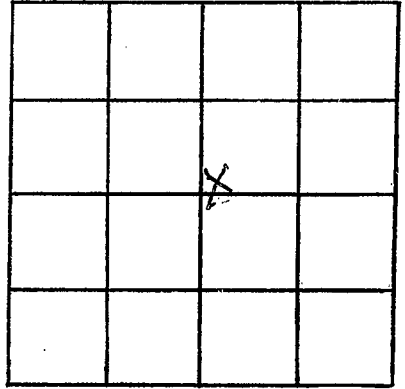

SECTION 14

Please indicate well location X.

ADDITIONAL INFORMATION

If more than one screen,  
show locations of each on sketch.