

MISSISSIPPI DEPARTMENT OF NATURAL RESOURCES

Bureau of Land and Water Resources

Southport Mall

P.O. Box 10631

Jackson, Mississippi 39209

WATER WELL DRILLERS LOG

CODED

F106
 Leflore Co.
 4-3-84

413184 19 J&K Irrigation Leflore
 date well completed firm name county well located

LANDOWNER: Watson P. How
Schlater

description of formations encountered	from	to
CLAY	0	28
SAND Stone	38	96

(mailing address)
 WELL LOCATION:
 sec. 20 (N) R. 2 (E)
4 miles W of Schlater
 (distance) (direction) (nearest town)

WELL PURPOSE: IRRIGATION
 (home, irrigation, municipal, industrial)

CODED

WELL COMPLETION DATA:

(1) diameter (inches) 1 1/2

(2) total depth (feet) 96

(3) static water level (feet) 31 below above top of ground.

(4) casing steel (material), 56' (depth),
16 (size) if telescope see back.

(5) screen 40' (length), 56' (depth to top),
16" (size), steel (material)

(6) pump 30 (HP), 1500 (yield gpm),
elect. (type power)

(7) electric log NO (yes or no)

(organization running log)

(8) how well bottom plugged plate

DRILLERS REMARKS:


DEPT. OF NATURAL RESOURCES
 BUREAU OF LAND & WATER RESOURCES

APR 12 1984

RECEIVED

If well telescopes please sketch and show depths.

GROUND LEVEL

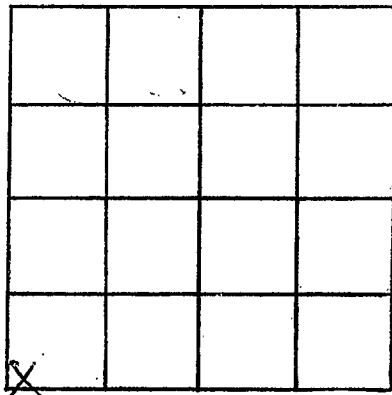

SECTION 4

Please indicate well location X.

ADDITIONAL INFORMATION

If more than one screen,
show locations of each on sketch.