

MISSISSIPPI DEPARTMENT OF NATURAL RESOURCES

Bureau of Land and Water Resources

Southport Mall

P.O. Box 10631

Jackson, Mississippi 39209

WATER WELL DRILLERS LOG

BUTANE GAS COMPANY

OF GREENWOOD

LEFLORE

F107

CODED

*Leflore*

5-30-84  
date well completed 79

county well located

LANDOWNER:

*D H Strains #1*

*Wadena Ms.*  
(mailing address)

description of formations encountered

*CLAY*

*SAND*

*sand & gravel*

*rock*

from

to

*0*

*25*

*25*

*55*

*55*

*97*

*97*

WELL LOCATION:

sec. *22* T. *200* N. R. *7 E*  
S. (W)  
*4* miles *SW* of *Schlater*  
(distance) (direction) (nearest town)

WELL PURPOSE: *irrigation*  
(home, irrigation, municipal, industrial)

WELL COMPLETION DATA:

- (1) diameter (inches) *16"*
- (2) total depth (feet) *97*
- (3) static water level (feet) *20'* <sup>(below)</sup> above top of ground.

(4) casing *Steel*, *57'*,  
(material) (depth)  
*16"* if telescope see back.  
(size)

(5) screen *40'*, *57'*  
(length) (depth to top)  
*16"*, *Steel*  
(size) (material)

(6) pump *60*, *1400*  
(HP) (yield gpm)  
*Diesel*  
(type power)

(7) electric log *No*  
(yes or no)  
*No*  
(organization running log)

(8) how well bottom plugged *steel plate*

DRILLERS REMARKS:  
*Richard Vest Sr.*

CODED


DEPT. OF NATURAL RESOURCES  
BUREAU OF LAND & WATER RESOURCES

JUN 18 1984

RECEIVED

If well telescopes please sketch and show depths.

GROUND LEVEL

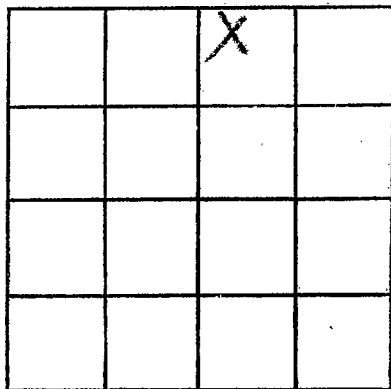

SECTION 22

Please indicate well location X.

ADDITIONAL INFORMATION

A series of horizontal lines for writing additional information.

If more than one screen, show locations of each on sketch.