

MISSISSIPPI DEPARTMENT OF NATURAL RESOURCES  
Bureau of Land and Water Resources

Southport Mall  
P.O. Box 10631

Jackson, Mississippi 39209  
WATER WELL DRILLERS LOG

**CODED**

**BUTANE GAS COMPANY  
OF GREENWOOD**

*Leflore*  
county well located

LEFLORE  
F108  
6/4/84

6-7 1984  
date well completed

LANDOWNER:  
A.H. Strain #2  
Schlater  
(mailing address)

description of formations encountered	from	to
<u>Clay</u>	<u>0</u>	<u>25</u>
<u>SAND</u>	<u>25</u>	<u>45</u>
<u>sand peagravel</u>	<u>45</u>	<u>85</u>
<u>gravel</u>	<u>85</u>	<u>98</u>
<u>rock</u>	<u>98</u>	

WELL LOCATION:  
sec. 22 T. 20 S. R. 2 E.  
4.5 miles SW of Schlater  
(distance) (direction) (nearest town)

WELL PURPOSE:  
(home, irrigation, municipal, industrial)

- WELL COMPLETION DATA:
- (1) diameter (inches) 16"
  - (2) total depth (feet) 98
  - (3) static water level (feet) 20 <sup>below</sup> above top of ground.
  - (4) casing Steel, 58'  
(material) (depth)  
16" if telescope see back.  
(size)
  - (5) screen 40', 58'  
(length) (depth to top)  
16", Steel  
(size) (material)
  - (6) pump 60, 1450  
(HP) (yield gpm)  
Quail  
(type power)
  - (7) electric log No  
(yes or no)  
No  
(organization running log)
  - (8) how well bottom plugged Steel plate

**CODED**

DEPT. OF NATURAL RESOURCES  
BUREAU OF LAND & WATER RESOURCES


JUN 18 1984

**RECEIVED**

DRILLERS REMARKS:  
Richard Vest

If well telescopes please sketch and show depths.

GROUND LEVEL

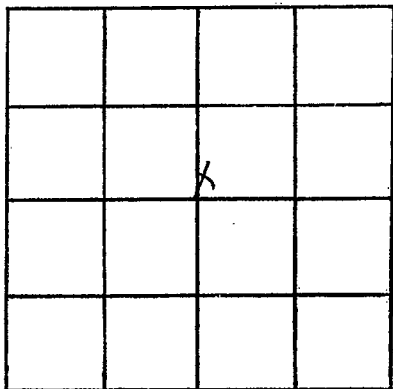

SECTION 22

Please indicate well location X.

ADDITIONAL INFORMATION

If more than one screen, show locations of each on sketch.