

MISSISSIPPI DEPARTMENT OF NATURAL RESOURCES

Bureau of Land and Water Resources

Southport Mall

P.O. Box 10631

CODED

Jackson, Mississippi 39209

WATER WELL DRILLERS LOG

BUTANE GAS COMPANY

Letlore

Letlore
F109
5/10/85

5-10
 date well completed

19*85*

OF GREENWOOD

county well located

LANDOWNER:
D.H. Strain
 (mailing address)

description of formations encountered	from	to
<i>Clay</i>	<i>0</i>	<i>25</i>
<i>fine sand</i>	<i>25</i>	<i>55</i>
<i>sand gravel</i>	<i>55</i>	<i>94</i>
<i>Rock</i>	<i>94</i>	<i>95</i>

WELL LOCATION:
 sec. *35* T. *19* N. R. *2* E. S. *5*
6 miles *N.W.* of *Itabene*
 (distance) (direction) (nearest town)

WELL PURPOSE:
 (home, irrigation, municipal, industrial)

- WELL COMPLETION DATA:
- (1) diameter (inches) *16"*
 - (2) total depth (feet) *95'*
 - (3) static water level (feet) *19'* *below* above top of ground.
 - (4) casing *Steel*, *55'*
 (material) (depth)
16" if telescope see back.
 (size)
 - (5) screen *40'* *55'*
 (length) (depth to top)
16" *steel*
 (size) (material)
 - (6) pump *80* *1100*
 (HP) (yield gpm)
Diene
 (type power)
 - (7) electric log *No*
 (yes or no)
No
 (organization running log)
 - (8) how well bottom plugged
Steel plate

RECEIVED


JUN 4 1985

DRILLERS REMARKS:
R-Vest

Department of Natural Resources
 Bureau of Land & Water Resources

If well telescopes please sketch and show depths.

GROUND LEVEL

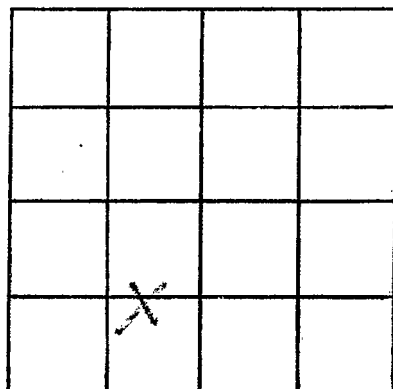

SECTION 25

Please indicate well location X.

ADDITIONAL INFORMATION

If more than one screen,
show locations of each on sketch.