

**MISSISSIPPI DEPARTMENT OF NATURAL RESOURCES**  
**Bureau of Land and Water Resources**  
 Southport Mall  
 P.O. Box 10631  
 Jackson, Mississippi 39209  
**WATER WELL DRILLERS LOG**

**CODED**

Leflore  
F 110

July 2 19 85 Bruce Berryman Leflore.  
 date well completed firm name county well located

**LANDOWNER:** James D. Gardner  
904 Newland St.  
Jackson, MS 39211  
 (mailing address)

**WELL LOCATION:**  
 sec. 34 T. 20 N. R. — E.  
                   S                  W  
5 miles N.W. of Tipton  
 (distance) (direction) (nearest town)

**WELL PURPOSE:** Home  
 (home, irrigation, municipal, industrial)

**WELL COMPLETION DATA:**

- (1) diameter (inches) 4" x 2"
- (2) total depth (feet) 1140'
- (3) static water level (feet) flow above  
 top of 4" blk - 126'  
 of gal - 1000'  
 (material) (depth)
- If telescope see back.  
 (size)
- (5) screen 20' 1020'  
 (length) (depth to top)
- 2" .010 ga. Stainless  
 (size) steel (material)
- (6) pump 1 1/2 18  
 (HP) (yield gpm)
- Electric  
 (type power)
- (7) electric log NO  
 (yes or no)
- (organization running log)
- (8) how well bottom plugged B.P.V.

description of formations encountered	from	to
Clay	0	30
Sand & Gravel	30	130
Clay	130	180
Sand	180	240
Clay	240	480
Sand	480	490
Clay	490	580
Shale & Rock	580	600
Green sand	600	640
Fine sand	640	660
Shale & sand	660	680
Rock & green sand	680	700
Shale & rock	700	720
Sand	720	730
Sand shale & rock	730	800
Brown sand	800	820
Clay	820	840
Brown sand	840	850
Shale	850	880
Fine brown sand	880	920
Shale sand & rock	920	960
Sandy shale	960	1060
Shale	1060	1100
Fine white sand	1100	1120
Sand	1120	1160

**CODED**


**RECEIVED**  
 FEB 18 1986

DRILLERS REMARKS:

Department of Natural Resources  
 Bureau of Land & Water Resources

If well telescopes please sketch and show depths.

GROUND LEVEL

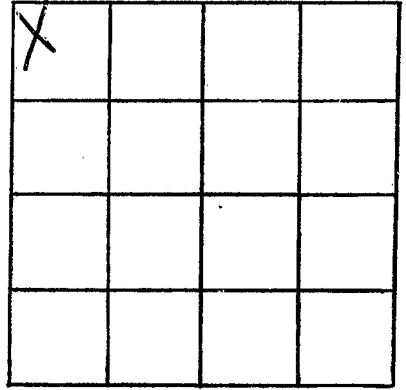

SECTION 34

Please indicate well location X.

ADDITIONAL INFORMATION

If more than one screen,  
show locations of each on sketch.