

MISSISSIPPI DEPARTMENT OF NATURAL RESOURCES

Bureau of Land and Water Resources

Southport Mall

P.O. Box 10631

Jackson, Mississippi 39209

WATER WELL DRILLERS LOG

Permit Applied For

~~LEPONS~~
F 114
Coded

3-1 1988 Dyer Well Leflore
date well completed firm name county well located

LANDOWNER: ELNOVA G. Taylor
RT 1 Box 192A
Schlater, Ms. 38952
(mailing address)


description of formations encountered	from	to
Clay	0	42
M. Sand & Gravel	42	60
Fine Sand	60	75
Sand & Gravel	75	108

WELL LOCATION:
sec 28 T 20 N R 2 S
10 miles W of Abbeville
(distance) (direction) (nearest town)

WELL PURPOSE: IRRIGATION
(home, irrigation, municipal, industrial)

WELL COMPLETION DATA:

(1) diameter (inches) 16"
(2) total depth (feet) 108'
(3) static water level (feet) _____ below top of ground.
(4) casing steel (material), (depth) _____
16 (size) if telescope see back.
(5) screen 40 (length), (depth to top) _____
16 (size) (material) _____
(6) pump 60 (HP) (yield gpm) _____
Elec (type power)
(7) electric log No (yes or no)
None (organization running log)
(8) how well bottom plugged Plate

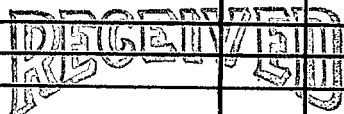


MAY 02 1988

Department of Natural Resources
Bureau of Land & Water Resources

DRILLERS REMARKS:

If well telescopes please sketch and show depths.

GROUND LEVEL

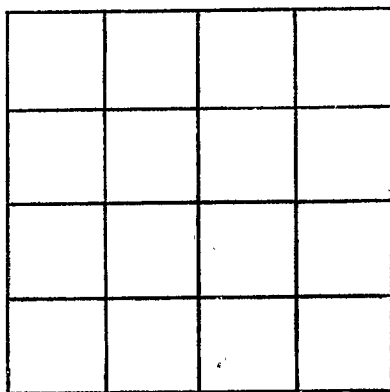

SECTION _____

Please indicate well location X.

ADDITIONAL INFORMATION

If more than one screen,
show locations of each on sketch.