

MISSISSIPPI DEPARTMENT OF NATURAL RESOURCES

Bureau of Land and Water Resources

Southport Mall

P.O. Box 10631

Jackson, Mississippi 39209

WATER WELL DRILLERS LOG

Permit  
Applied For  
LEPROUS

Coded  
F 116 0076

4-21-88  
date well completed

88 Days Well  
firm name

Leflore  
county well located

LANDOWNER: D. H. Strain

description of formations encountered

from

to

Rt 1 Box 185 Farms

Clay  
Sand & Gravel

0 38  
38 112

Ita Bena Ms. 38941  
(mailing address)

WELL LOCATION:

128 D sec 23 T 20 N R 2 E  
6 miles S of Schlater  
(distance) (direction) (nearest town)

WELL PURPOSE: Irrigation  
(home, irrigation, municipal, industrial)

WELL COMPLETION DATA:

(1) diameter (inches) 16"  
(2) total depth (feet) 112'

(3) static water level (feet) \_\_\_\_\_ below above top of ground.

(4) casing steel (material), (depth)

16" if telescope see back.  
(size)

(5) screen 40' (length), (depth to top)

16" (size), (material)

(6) pump 60 3000 (HP) (yield gpm)

Elec (type power)

(7) electric log No (yes or no)

None (organization running log)

(8) how well bottom plugged Plate

RECEIVED


MAY 02 1988

Department of Natural Resources  
Bureau of Land & Water Resources

DRILLERS REMARKS:

If well telescopes please  
sketch and show depths.

GROUND LEVEL

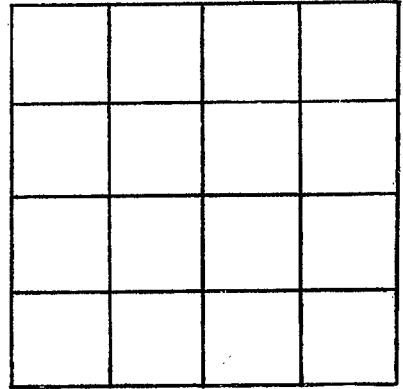

SECTION \_\_\_\_\_

Please indicate well location X.

ADDITIONAL INFORMATION

If more than one screen,  
show locations of each on sketch.