

MISSISSIPPI DEPARTMENT OF NATURAL RESOURCES

Bureau of Land and Water Resources

Southport Mall

P.O. Box 10631

Jackson, Mississippi 39209

WATER WELL DRILLERS LOG

TEP
88187-PMG
01F118

CODED

7-2 1988 Dyer Well Leflore
date well completed firm name county well located

LANDOWNER: Leflore Co.
Court House
D'wood Ms 38930
(mailing address)

description of formations encountered	from	to
Clay	0	30
Sand	30	36
M Sand & Gravel	36	70
Sand & Gravel	70	100
M Sand & Gravel	100	108

WELL LOCATION:
sec 16 T 20 N R 2 E
4 miles S of Schlater
(distance) (direction) (nearest town)

WELL PURPOSE: Irrigation
(home, irrigation, municipal, industrial)

- WELL COMPLETION DATA:
- (1) diameter (inches) 16"
 - (2) total depth (feet) 109'
 - (3) static water level (feet) _____ below above top of ground
 - (4) casing steel (material) (depth) 16" If telescope see back. (size)
 - (5) screen 40' (length) (depth to top) 16" (size) (material)
 - (6) pump 60 (HP) (yield gpm) Elec (type power)
 - (7) electric log No (yds or no) None (organization running log)
 - (8) how well bottom plugged Plate

RECEIVED


JUL 11 1988

Department of Natural Resources
Bureau of Land & Water Resources

DRILLERS REMARKS:

If well telescopes please sketch and show depths.

GROUND LEVEL

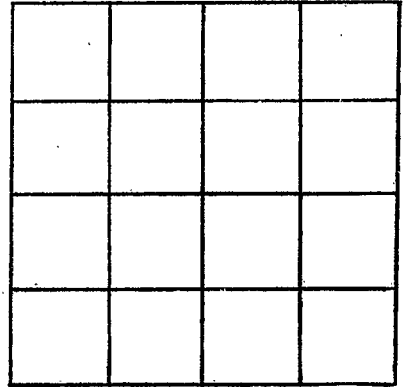

SECTION _____

Please indicate well location X.

ADDITIONAL INFORMATION

If more than one screen,
show locations of each on sketch.