

MISSISSIPPI DEPARTMENT OF ENVIRONMENTAL QUALITY
Bureau of Land and Water Resources

P. O. Box 10631
Jackson, MS 39289-0631
WATER WELL DRILLERS LOG

COUNTY WELL LOCATED <u>LeFlore</u>	
WELL NUMBER <u>F124</u>	CODED <input checked="" type="checkbox"/>
DATE WELL COMPLETED <u>7-5-91</u>	

PERMIT NUMBER
NAME OF DRILLING FIRM <u>CBS Drillers</u>

NAME & MAILING ADDRESS OF LANDOWNER <u>Holly Wood Farms</u> <u>P.O. Box 460</u>		
WELL LOCATION: SEC <u>3</u> TOWNSHIP <u>20 N</u> RANGE <u>2 W</u>		
DISTANCE <u>5</u> Miles	DIRECTION <u>NW</u>	NEAREST TOWN <u>Greenwood</u>
OTHER LANDMARK		
WELL PURPOSE <input checked="" type="checkbox"/> Home Irrigation, <input type="checkbox"/> Municipal, <input type="checkbox"/> Industrial, <input type="checkbox"/> Fish Pond, etc.		

PUMP DATA		
PUMP TYPE (Circle One): <input checked="" type="checkbox"/> Submersible, <input type="checkbox"/> Turbine, <input type="checkbox"/> Jet, <input type="checkbox"/> Flowing Well, Other (Describe) _____		
POWER TYPE (Circle One): <input checked="" type="checkbox"/> Electric, <input type="checkbox"/> Tractor, <input type="checkbox"/> Diesel, <input type="checkbox"/> Gasoline, <input type="checkbox"/> Butane, Other (Describe) _____ H/P _____		
Pump Capacity (GPM) <u>20</u>	No. of Stages <u>9</u>	Setting Depth <u>63</u> FT.
PUMP TEST		
Well yielded <u>20</u> GPM with a drawdown of <u>18</u> ft. after <u>12</u> hours of pumping		

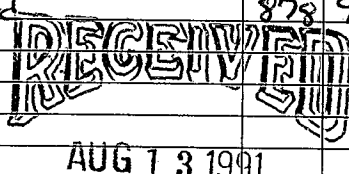
WELL DATA		
Well Depth <u>921</u>	Casing Diameter (In.) <u>4" x 2"</u>	Casing Length (Ft.) <u>921 891</u>
Type of Casing <u>Steel</u>	Hole Depth <u>935</u>	Depth to Static Water Level <u>22</u>
TYPE OF COMPLETION: (Circle One or More): <input checked="" type="checkbox"/> Gravel Packed, <input type="checkbox"/> Underreamed, <input type="checkbox"/> Telescoped, <input checked="" type="checkbox"/> Natural Development, <input type="checkbox"/> Open Hole, <input type="checkbox"/> Other (Describe) _____		
Top of Lap Pipe or Reduction in Casing FEET <input type="checkbox"/> IF TELESCOPED OR MORE THAN ONE SCREEN: USE BACK PAGE		

LOG DATA	
TYPE OF LOG RUN (Circle One): <input checked="" type="checkbox"/> No Log Run, <input type="checkbox"/> Electric, <input type="checkbox"/> Gamma Ray, <input type="checkbox"/> Density, <input type="checkbox"/> Sonic, <input type="checkbox"/> Neutron, Other (Describe) _____	
Name of Organization Running Log	

SCREEN DATA		
Diameter - Inches <u>2"</u>	Length - Feet <u>30</u>	Slot Size - Inches <u>.010</u>
Screen Type	Depth to Bottom - Feet	

GEOLOGIC DATA (Office Use Only)			
Surface Elev.	Geologic Unit	Unit Thickness	Depth to Top
Subs. SWL	Date	Analysis	Aquifer Test

Driller's Remarks

DESCRIPTION OF FORMATIONS ENCOUNTERED	FROM	TO	FORMATIONS (Continued)	FROM	TO
TOP SOIL & Clay	0	32	Clay & ST. Sand	721	878
Fine Sand	32	49	Sand	878	935
Coarse Sand (Gravel)	49	138			
Clay	138	156			
Sand	156	245			
Clay	245	267			
Sand	267	340			
Rock	340	342			
Clay	342	406			
Sand	406	463			
Clay	463	721			

IF MORE SPACE IS NEEDED, USE BACK

If well telescopes please
sketch and show depths.

GROUND LEVEL

X			

SECTION 3

Please indicate well location X.

ADDITIONAL INFORMATION

If more than one screen,
show location of each on sketch.