

MISSISSIPPI DEPARTMENT OF ENVIRONMENTAL QUALITY
Office of Land and Water Resources

P. O. Box 10631
Jackson, MS 39289-0631
WATER WELL DRILLERS LOG

COUNTY WELL LOCATED Leflore	
WELL NUMBER F-153	CODED
DATE WELL COMPLETED 6-26-03	

PERMIT NUMBER MSGW-39354
NAME OF DRILLING FIRM Irrigation Equipment Inc.
Indianola, MS

NAME & MAILING ADDRESS OF LANDOWNER Prestidge Farms 37301 County Rd 523 Schlater, MS 38952
--

Latitude:
Longitude:

WELL LOCATION.	SEC	TOWNSHIP	RANGE
SE/NE	33	20N S	2W W

DISTANCE	DIRECTION	NEAREST TOWN
Miles	NW	Itta Bena

OTHER LANDMARK

WELL PURPOSE: Home, Irrigation, Municipal, Industrial, Fish Pond, etc.
Irrigation

WELL DATA

Well Depth 125	Casing Diameter (In.) 16	Casing Length (Ft.) 85
Type of Casing pvc	Hole Depth 125	Depth to Static Water Level 51ft.

TYPE OF COMPLETION: (Circle One or More):
 Gravel Packed, Underreamed, Telescoped,
 Natural Development, Open Hole, Other
(Describe)

WELL GROUTED TO A DEPTH OF **10** FEET
Type Grout (circle one): Cement, Bentonite, or Mix

SCREEN DATA

Diameter - Inches 16	Length - Feet 40	Slot Size - Inches .050
Screen Type pvc	Depth to Bottom - Feet 125	

PUMP DATA

PUMP TYPE (Circle One):
 Submersible, Turbine, Jet Flowing Well,
Other (Describe)

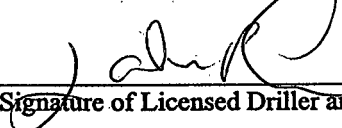
POWER TYPE (Circle One):
 Electric, Tractor, Diesel, Gasoline, Butane,
Other (Describe) H/P **40**

DESCRIPTION OF FORMATIONS ENCOUNTERED	FROM	TO
Clay	0	28
Fine Sand	29	35
Fine Sand/gravel	36	45
Med. Sand/gravel	46	125

RECEIVED
JUL 18 2003
BY: OLWR

Top of Lap Pipe or Reduction in Casing
FEET IF TELESCOPED OR MORE THAN ONE SCREEN: USE BACK PAGE

I certify that the well was drilled, constructed and completed in accordance with all applicable Requirements of the Mississippi Department of Environmental Quality and/or the Mississippi Department of Health regulations and state laws.

 0439
Signature of Licensed Driller and License No.

7-14-03
Date

Additional Information Required On Back

If well telescopes please sketch and show depths.

GROUND LEVEL

			X

SECTION 33

Please indicate well location X.

Pump Capacity (GPM)	No. of Stages	Setting Depth
2000	2	70 FT.

PUMP TEST

Well yielded _____ GPM with
a drawdown of _____ ft.
after _____ hours of pumping

LOG DATA

TYPE OF LOG RUN (Circle One): No Log Run, Electric, Gamma Ray, Density, Sonic, Neutron, Other (Describe) _____

Name of Organization Running Log _____

GEOLOGIC DATA (Office Use Only)

Surface Elev.	Geologic Unit	Unit Thickness	Depth to Top
Subs. SWL	Date	Analysis	Aquifer Test

Driller's Remarks

If more than one screen, show location of each on sketch.