County:L	eflore <u>3980</u> 0	H Mississippi Departmen	Vell Report Part 1 Int of Environmental Quality	For Office Use Only:	
Irrigati	Permit #: <u>OW</u> <u>39800</u> Crrigation Equipment Date drilling completed: <u>8-17-04</u> Mississippi Department of Em Office of Land and Wa P.O. Box 10 Jackson, MS 392 (601)961-52 (601)354-6938		Box 10631 MS 39289-0631)961-5210	Well #: L. S. Elevation: E-log #:	
	f completion of drilling	ng of the well.	e driller in detail and filed w	•	
Owner Name	Well Owner Inform Tackett Fis			Location Longitude: <u>90</u> 26, 50W	
	23939 Count	y Road 523	Method of Lat/Long (circle or	-	
	Schlater, City 5 662-254-7322	State Zip Code	USGS quad, Hand-held <u>SE</u> 4 <u>NW</u> 4 Sec_30 Distance <u>Direction</u> <u>8</u> Miles	IGPS, Survey-grade GPS TwnRng Nearest Town ofSchlater	
Purnose of Well	· · · · · · · · ·	Well		P-Pond Replacement	
	(circle one) Home I	Industrial Public Supply	Irrigation Fish Cultur		
Date well drillin If flowing, meth	ng started:8	Valve Other (well drilling completed:	8-17-04	
Date well drillin If flowing, meth Static Water Lev Method of Meas Hole depth:	ig started:8 od of flow regulation: V vel:55ft.feet surement (circle one) $($	-17-04 Date Valve Other (above r below (circle one) steel tape electric tape depth: 128 '	well drilling completed: describe) land surface Date measured: e air line other: Well grouted to a depth of	8-17-04	
Date well drillin If flowing, meth Static Water Lev Method of Meas Hole depth: Type of grout (c Casing length: _	ag started: 8 iod of flow regulation: 128 · feet surement (circle one) 6 128 ' Well 9 sircle one): Cement 88 feet Ca 40 40	-17-04 Date Valve Other (above r below (circle one) steel tape electric tape depth: 128 ' Bentonita Mix asing diameter: 16	well drilling completed: describe) land surface Date measured: air line other: Well grouted to a depth of inches Type of casing: P	8-17-04 8-17-04 10 feet VC Sch. 40 VC Sch. 40	
Date well drillin If flowing, meth Static Water Lev Method of Meas Hole depth: Type of grout (c	ag started: 8 iod of flow regulation: 1 wel: $55ft.$ feet surement (circle one) 6 128' Well wircle one): Cement 88 feet Ca 40 feet So	Date Date Valve Other (d above r below (circle one) Steel type electric tape depth: 128 ' Mix asing diameter: 16 16	well drilling completed: describe) land surface Date measured: e air line other: Well grouted to a depth of inches Type of casing: P inches Type of screen:	8-17-04 8-17-04 10 feet VC Sch. 40 VC Sch. 40	
Date well drillin If flowing, meth Static Water Lev Method of Meas Hole depth: Type of grout (c Casing length: _ Screen length: _ Screen slot size:	ag started: 8 iod of flow regulation: 1 wel: $55ft.$ feet surement (circle one) 6 128' Well wircle one): Cement 88 feet Ca 40 feet So	Date Date Date Date Date Date Date Date	well drilling completed: describe) land surface Date measured: air line other: Well grouted to a depth of _ inches Type of casing: inches Type of screen: 8.7 feet to freet to 1 meamed Telescoped Open	8-17-04 8-17-04 10 feet VC Sch. 40 VC Sch. 40 26 feet bole Natural Development	
Date well drillin If flowing, meth Static Water Lev Method of Meas Hole depth: Type of grout (c Casing length: _ Screen length: _ Screen slot size: Type of complet	ag started: 8 iod of flow regulation: V wel: $55ft.feet$ surement (circle one) (128' Well sircle one): Cement 88 feet Ca 40 feet Sa .050 inches	Date Date Date Date Date Date Date Date	well drilling completed: describe) land surface Date measured: e air line other: Well grouted to a depth of inches Type of casing:	8-17-04 8-17-04 <u>10</u> feet VC Sch. 40 VC Sch. 40 <u>26</u> feet hole Natural Development	
Date well drillin If flowing, meth Static Water Lev Method of Meas Hole depth: Type of grout (c Casing length: _ Screen length: _ Screen slot size: Type of complet Top of lap pipe of	ag started:8 and of flow regulation: V vel:55ft.feet surement (circle one) (128' Well incle one): Cement <u>88</u> feet Ca 40feet Sa .050inchest tion (circle all applicables or reduction in casing:	Date Date Date Date Date Date Date Date	well drilling completed: describe) land surface Date measured: air line other: Well grouted to a depth of _ inches Type of casing: inches Type of screen: 8.7 feet to freet to 1 meamed Telescoped Open	8-17-04 8-17-04 10 feet VC Sch. 40 VC Sch. 40 26 feet bole Natural Development reen, describe on back of page	
Date well drillin If flowing, meth Static Water Lev Method of Meas Hole depth: Type of grout (c Casing length: _ Screen length: _ Screen slot size: Type of complet Top of lap pipe of Logs run (circle Name of organiz	ag started:8 and of flow regulation: V vel:55ft.feet surement (circle one) (128' Well ircle one): Cement 88 feet Ca 40 feet So feet So 	Date Date Date Date Date Date Date Date	well drilling completed: describe) land surface Date measured: air line other: Well grouted to a depth of inches Type of casing: inches Type of screen: 87 feet to 1 meamed Telescoped elescoped or more than one scr v Density	8-17-04 8-17-04 <u>10</u> feet <u>VC Sch.40</u> <u>26</u> feet hole Natural Development veen, describe on back of page Other:	
Date well drillin If flowing, meth Static Water Lev Method of Meas Hole depth: Type of grout (c Casing length: Screen length: Screen slot size: Type of complet Top of lap pipe of Logs run (circle <u>Name of organiz</u> I certify that th Department of Irriga	ag started: sod of flow regulation: V vel:	Date Date Date Date Date Date Date Date	well drilling completed: describe) land surface Date measured: air line other: Well grouted to a depth of inches Type of casing: inches Type of screen: 87 feet to 1 meamed Telescoped elescoped or more than one scr v Density	8-17-04 8-17-04 <u>10</u> feet VC Sch. 40 VC Sch. 40 <u>26</u> feet hole Natural Development veen, describe on back of page Other:	


AUG 3 0 2004 BY: OLWR If well telescopes please sketch below and show depths.



	Description of Formations Encountered	From	То
	Clay	0	28
	Fine Sand	Ž9	35
	Fine Sand/gravel	36	50
	Fine Sand/gravel Med. Sand/gravel	51	127
	Fine Sand	128	,
	·		
:			
	· · · · · · · · · · · · · · · · · · ·		

If more than one screen, show location of each on sketch

Sketch the property layout and include the following: 1) the well location; 2) any permanent structures on the property that may aid in locating the well; 3) any roads, power lines, or other items that may aid in locating the property and the well; 4) indicate direction.

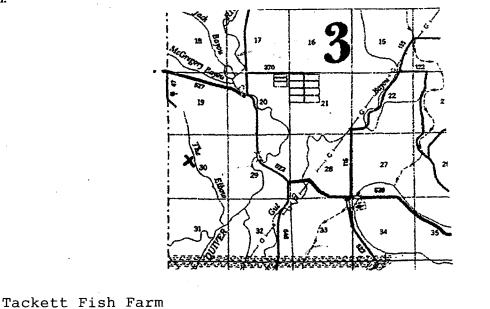

Landowner Name:

Signature of Water Well Contractor

	STATE W	ELL REPORT		
County: Leflore Permit #: <u>Gw 39800</u> Irrigation Equipment Driller:	Part 2 Pump Installer's Completion Report Mississippi Department of Environmental Quality Office of Land and Water Resources P.O. Box 10631 Jackson, MS 39289-0631 (601)961-5210		For Office Use Only: Aquifer: Well #: F-160	
(601)3		54-6938 (fax)	Elevation:	
This report should be prepared by the installation of pump.			• .	
Well Owner Informati		Well Location		
Dwner Name: Tackett Fish		Latitude:	_ Longitude:	
Aailing Address:23939 County	Road 523	Method of Lat/Long (circle or	-	
Schlater, M		SE NW SU	d-held GPS, Survey-grade GPS 30 Twn_20N Rng_2W	
City State 662-254-7322 Telephone No. ()	-		Nearest Town	
Pump Type Circle one	· · · ·		wer Type Ercle one	
Air Lift Jet	Submersible		ne Engine Natural Gas	
Bucket Piston	Turbine	Electric Motor Hand	Tractor PTO	
entrifugal Rotary	Flowing Well	Windmill Other	(specify):	
ther (specify):		Horse Power Rating of Motor	60 	
Date Pump Installed: $8-17-04$		Setting Depth:	80feet	
2500	Gallons Per Minute	Number of Stages:2	2	
Pump Test Data			easuring Water Level	
Date Well Tested:		Air Line Electric Mea	asuring Line Steel Tere	
umping Water Level (B):Feet E		Other (specify):		
rawdown [(B) - (A)]:Feet 1	Below Land Surface	For flowing well, measured sl	but in head:feet	
est Pumping Rate:	Gallons Per Minute	Well yielded	GPM with a drawdown of	
Duration of Pump Test (minimum 4 hours):	hours	feet after _	hours of pumping	
HEREBY CERTIFY that the above statemed Patrick M. Chism	ents are true to the best 0695	of my knowledge.	Chus	

AUG 3 0 2004 BY: OLWR