County: Leflore Permit #: <u>GW38944</u> Irrigation Equipment Driller: <u>7-5-05</u> State Law requires that this repo	State Well Report Part 1 Mississippi Department of Environmental Qua Office of Land and Water Resources P.O. Box 10631 Jackson, MS 39289-0631 (601)961-5210 (601)354-6938 (fax)	Well #: <u>F- 166</u> L. S. Elevation: E-log #:
30 days of completion of drilling Well Owner Informa	ution	Well Location
Tackett Fish Fa: Owner Name	rm Latitude: 33 • 34	. 52 " Longitude: 90 . 26 . 25 .
Mailing Address: 23939 Count		rcle one): Conventional Survey,
	USGS quad, Hand	d-held GPS,Survey-grade GPS
	SE 1/4 Sec	19 _{Twn} 20N _{Rng} 2W
<u>Schlater, Mi</u> City Stat 662-254-73 Telephone No. ()	S38952teZip CodeDistance227MilesSW	tion Nearest Town of <u>Schlater</u>
	Well Data	P-25
Date well drilling started: 7-5-	0 5 Date well drilling completed:	7-5-05
Static Water Level: 61' feet ab Method of Measurement (circle one) Static Water Level: Hole depth: 117 Type of grout (circle one): Cement Casing length: 67 feet Casin Screen length: 50 feet Screet Screen slot size: 050 inches Type of completion (circle all applicable):	117' Well grouted to a depth Bentonits Mix ng diameter: 16 inches Type of casis en diameter: 16 inches Type of screet Setting depth: From 65 feet to Gravel packed Underreamed Other (describe):	aured: 7-6-05 h of <u>10</u> feet ing: <u>PVC Sch.40</u> een: <u>PVC Sch.40</u> <u>114</u> feet Open hole Natural Development me screen, describe on back of page
Static Water Level: 61' feet ab Method of Measurement (circle one) Static Water Level: Hole depth: 117 Type of grout (circle one): Cement Casing length: 67 feet Casin Screen length: 50 feet Screet Screen slot size: 050 inches Type of completion (circle all applicable): Top of lap pipe or reduction in casing:	nove or below (circle one) land surface Date measures neel tape electric tape air line other: net: 117' Well grouted to a depth Bentonite Mix ng diameter: 16 inches Type of casis en diameter: 16 inches Type of screet Setting depth: From 65 feet to Gravel packed Underreamed Telescoped Other (describe):	aured: 7-6-05 h of <u>10</u> feet ing: <u>PVC Sch.40</u> een: <u>PVC Sch.40</u> <u>114</u> feet Open hole Natural Development me screen, describe on back of page
Static Water Level: 61' feet ab Method of Measurement (circle one) Static Water Level: Hole depth: 117 Well dept 117 Type of grout (circle one): Cement Casing length: 67 feet Casin Screen length: 50 feet Screen Screen slot size: 050 inches Type of completion (circle all applicable): Top of lap pipe or reduction in casing: Logs run (circle all applicable): No log run Name of organization running log(s):	nove or below (circle one) land surface Date measures cel tape electric tape air line other: 117' Well grouted to a depth Bentonite Mix ng diameter: 16 inches Type of casis en diameter: 16 inches Type of screet Setting depth: From 65 feet to Gravel packed Underreamed Telescoped Other (describe):	aured: 7-6-05 h of 10 feet ing: PVC Sch.40 een: PVC Sch.40 114 feet Open hole Natural Development me screen, describe on back of page ron Other:
Static Water Level: 61' feet ab Method of Measurement (circle one) Static Water Level: Hole depth: 117 Type of grout (circle one): Cement Casing length: 67 50 feet Screen length: 50 Screen slot size: 050 Type of completion (circle all applicable): Top of lap pipe or reduction in casing: Logs run (circle all applicable): No log run Name of organization running log(s): I certify that the well was drilled, construction	nove or below (circle one) land surface Date measures cel tape electric tape air line other: 117' Well grouted to a depth Bentonite Mix ng diameter: 16 inches Type of cash en diameter: 16 inches Type of screeter Setting depth: From 65 feet to Gravel packed Underreamed Telescoped Other (describe):	aured: 7-6-05 h of 10 feet ing: PVC Sch. 40 en: PVC Sch. 40 114 feet Open hole Natural Development me screen, describe on back of page ron Other: icable requirements of the Mississipp

r

۰...


JUL 2 2 2005 BY: OLWR If well telescopes please sketch below and show depths.

Ground Level

...

	F-166
Description of Formations Encountered Clay Fine Sand/gravel Med. Sand/gravel Fine Sand	From To 0 31 32 50 51 114 115117

If more than one screen, show location of each on sketch

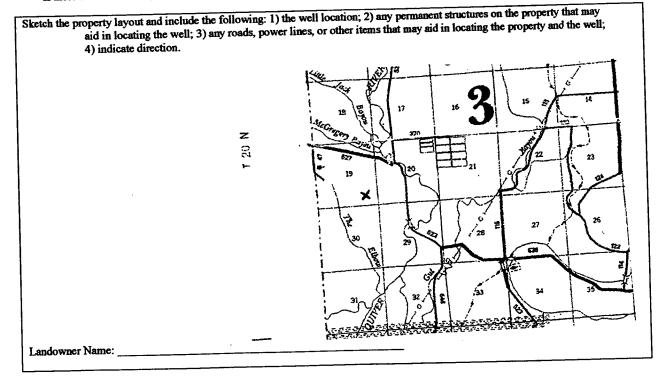

Chin

Signature of Water Well Contractor

STATE WELL REPORT				
County:Leflore	Part 2 Pump Installer's Completion Report	For Office Use Only:		
Pamit#: Irrigation Equipment	Mississippi Department of Environmental Quality Office of Land and Water Resources	Aquifer:		
Drile:	P.O. Box 10631 Jackson, MS 39289-0631	Well#: F · 166		
Date completed:7-6-05	(601)961-5210 (601)354-6938 (fax)	Elevation:		

• •

• • •

.

This report should be prepared by the pump installer in detail and filed with the Department within 30 days of the installation of pump.

Well Owner Information	Well Location		
Tackett Fish Farm Owner Name:	Latitude:Longitude:		
Mailing Address: 23939 County Road 523	Method of Lat/Long (circle one): Conventional Survey,		
	USGS quad, Hand-held GPS, Survey-grade GPS		
Schlater, MS 38952	SE ¼ SE ¼ Sec 19 Twn20N Rng 2W		
City State Zip Code	·, ·, ·		
662-254-7322	Distance Direction Nearest Town		
Telephone No. ()	7 Miles SW of Schlater		

	Pump Typ Circle on			Power Type Circle one	·
Air Lift	Jet	Submersible	Diesel Engine	Gasoline Engine	Natural Gas
Bucket	Piston	Turbine	Electric Motor	Hand	Tractor PTO
Centrifugal	Rotary	Flowing Well	Windmill	Other (specify):	
Other (specify):			Horse Power Ratin	g of Motor:60	
Date Pump Installed:		7-6-05	Setting Depth:	80	feet
Rated Pump Capacity:	2500	Gallons Per Minute	Number of Stages:	2	

Pump Test Data	Method of Measuring Water Level Circle one	
Date Well Tested:		
Static Water Level (A):Feet Below Land Surface	Air Line Electric Measuring Line Steel Tape	
Pumping Water Level (B):Feet Below Land Surface	Other (specify):	
Drawdown [(B) - (A)]:Feet Below Land Surface	For flowing well, measured shut in head:feet	
Test Pumping Rate:Gallons Per Minute	Well yielded GPM with a drawdown of	
Duration of Pump Test (minimum 4 hours): hours	feet afterhours of pumping	

I HEREBY CERTIFY that the above statements are true to the best of my knowledge.			
Patrick M. Chism 0695	Jahrie M Chim		
Print Name of Pump Installer and License No. (if applicable)	Signature of Pump Installer		
		RECEIVED	

JUL 2 2 2005 BY: OLWR