Permit #: <u>Garage Garage</u> Mississippi Departm. Irrigation Equipment Driller: Date drilling completed:7-19-05 (60) (601):	Well Report Part 1 ent of Environmental Quality d and Water Resources 0. Box 10631 MS 39289-0631 01)961-5210 354-6938 (fax) he driller in detail and filed with the Department within		
Well Owner Information	Well Location		
Owner Name Prestidge Farms	Latitude:'' Longitude:'"		
Mailing Address: 37301 County Road 523	Method of Lat/Long (circle one): Conventional Survey,		
	USGS quad, Hand-held GPS, Survey-grade GPS		
	NE ¹ / ₄ NW ¹ / ₄ Sec 2 Twn 20N Rng 2W		
Schlater, MS 38952 City State ZipCode	Distance Direction Nearest Town		
$\frac{662 - 254 - 6408}{1 - 254 - 6408}$			
	II D.4		
	il Data		
· · · · · · · · · · · · · · · · · · ·	Fish Culture Other.		
Date well drilling started: 7-19-05 Date well drilling completed: 7-19-05			
Date well drilling started: Dat	te well drilling completed:		
If flowing, method of flow regulation: Valve Other	(describe)		
If flowing, method of flow regulation: Valve Other Static Water Level:38 'feet above of below (circle one	$\frac{(\text{describe})}{(\text{describe})} = \frac{1}{2}$ $\frac{1}{2} \text{ (describe)} = \frac{1}{2} = \frac{1}{2}$ $\frac{1}{2} \text{ (describe)} = \frac{1}{2} = $		
If flowing, method of flow regulation: Valve Other Static Water Level:38 'feet above of below (circle one Method of Measurement (circle one) steel uppe electric ta Hole depth:125 ' Well depth:125 ' Type of grout (circle one): Cement Bentonie Mi Casing length:90feet Casing diameter: 16	(describe) e) land surface Date measured: 7-19-05 pe air line other: Well grouted to a depth of 10feet ix inches Type of casing: PVC Sch.40		
If flowing, method of flow regulation: Valve Other Static Water Level:38 ' feet above or before (circle one Method of Measurement (circle one) steel type electric ta Hole depth:125 ' Well depth:125 ' Type of grout (circle one): Cement Bentonite Mi	(describe) e) land surface Date measured: 7-19-05 pe air line other: Well grouted to a depth of 10feet ix inches Type of casing: PVC Sch.40		
If flowing, method of flow regulation: Valve Other Static Water Level:38 'feet above of below (circle one Method of Measurement (circle one) steel uppe electric ta Hole depth:125 ' Well depth:125 ' Type of grout (circle one): Cement Bentonie Mi Casing length:90feet Casing diameter: 16	<pre>(describe)</pre>		
If flowing, method of flow regulation: Valve Other Static Water Level: 38 ' feet above or below (circle one) Method of Measurement (circle one) Method of Measurement (circle one) Hole depth: 125 ' Well depth: 125 ' Type of grout (circle one): Cement Bentonice Mit Casing length: 90 feet Screen diameter: 16 Screen slot size: 050 inches	(describe) e) land surface Date measured: 7-19-05 pe air line other:		
If flowing, method of flow regulation: Valve Other Static Water Level:38 ' feet above or before (circle one Method of Measurement (circle one) steel type electric tag Hole depth:125 ' Well depth:125 ' Type of grout (circle one): Cement Bentonite Mit Casing length:90 feet Casing diameter: 16 Screen length:35 feet Screen diameter: 16 Screen slot size:050 inches Setting depth: From Type of completion (circle all applicable): Cravel packet Und	(describe) (e) land surface Date measured: 7-19-05 (pe air line other: (minimum Well grouted to a depth of 10 feet (ix (inches Type of casing: PVC Sch. 40 (inches Type of screen: PVC Sch. 40		
If flowing, method of flow regulation: Valve Other Static Water Level: 38 ' feet above or before (circle one) Method of Measurement (circle one) steel type electric ta Hole depth: 125 ' Well depth: 125 ' Type of grout (circle one): Cement Bentonite Mi Casing length: 90 feet Casing diameter: 16 Screen length: 35 feet Screen diameter: 16 Screen slot size: 050 inches Setting depth: From Type of completion (circle all applicable): travel packed United Screen (describe): 00 Other (describe): 00 Streen (describe):	(describe) (e) land surface Date measured: (pe air line other: (minute weights) (minute weight		
If flowing, method of flow regulation: Valve Other Static Water Level: 38 'feet above or below (circle one Method of Measurement (circle one) steel type electric tag Hole depth: 125 ' Type of grout (circle one): Cement Bentonite Mi Casing length: 90 feet Casing diameter: 16 Screen length: 55 feet Screen diameter: 16 Screen slot size: 050 inches Setting depth: From Type of completion (circle all applicable): Case Univ Other (describe):	: (describe)		
If flowing, method of flow regulation: Valve Other Static Water Level: 38 ' feet above or below (circle one Method of Measurement (circle one) steel type electric ta Hole depth: 125 ' Well depth: 125 ' Type of grout (circle one): Cement Bentonite Mi Casing length: 90 feet Casing diameter: 16 Screen length: 35 feet Screen diameter: 16 Screen slot size: 050 inches Setting depth: From Type of completion (circle all applicable): travel packed Une Other (describe): Top of lap pipe or reduction in casing: feet. If Logs run (circle all applicable): to log run Electric Gamma R Name of organization running log(s):	(describe)		
If flowing, method of flow regulation: Valve Other Static Water Level: 38 ' feet above or below (circle one Method of Measurement (circle one) steel type electric ta Hole depth: 125 ' Well depth: 125 ' Type of grout (circle one): Cement Bentonite Mit Casing length: 90 feet Casing diameter: 16 Screen length: 5 feet Screen diameter: 16 Screen slot size: 050 inches Setting depth: From Type of completion (circle all applicable): travel packed Und Other (describe): Top of lap pipe or reduction in casing: feet. If Logs run (circle all applicable): to log run Electric Gamma R Name of organization running log(s): I certify that the well was drilled, constructed, and completed in	(describe) e) land surface Date measured: 7-19-05 pe air line other: Well grouted to a depth of 10feet ix		
If flowing, method of flow regulation: Valve Other Static Water Level: 38 ' feet above or below (circle one Method of Measurement (circle one) steel type electric ta Hole depth: 125 ' Well depth: 125 ' Type of grout (circle one): Cement Bentonite Mi Casing length: 90 feet Casing diameter: 16 Screen length: 35 feet Screen diameter: 16 Screen slot size: 050 inches Setting depth: From Type of completion (circle all applicable): travel packed Une Other (describe): Top of lap pipe or reduction in casing: feet. If Logs run (circle all applicable): to log run Electric Gamma R Name of organization running log(s):	(describe) e) land surface Date measured: 7-19-05 pe air line other: Well grouted to a depth of 10feet ix		

æ 1 ...

AUG 0 / 2005 BY: OLWF


F- 170

If well telescopes please sketch below and show depths.

Ground Level

Description of Formations Encountered	From	То
	0	31
Clay Fine Sand	32	42
Fine Sand/gravel	43	59
Fine Sand/gravel Med. Sand/gravel Fine Sand	60	82
Fine Sand	83	87
Med. Sand/gravel	88	125
		
······································	 	
	ļ	
· · · · · · · · · · · · · · · · · · ·	ļ	
	<u> </u>	
	ļ	
	ļ	
	<u> </u>	
	<u> </u>	ļ
		
		ļ
	l	
	<u> </u>	
	<u> </u>	
	₋	ļ

If more than one screen, show location of each on sketch

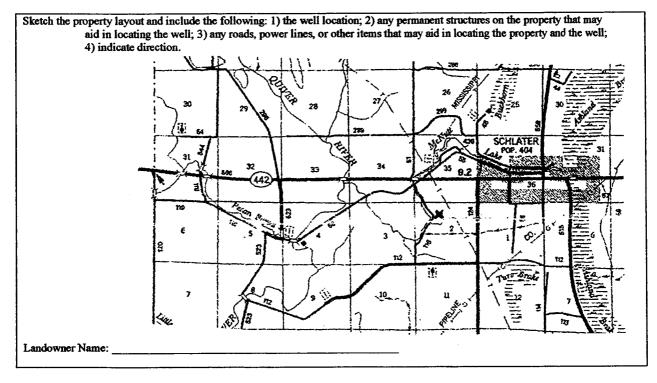

Patrick M Chains Signature of Water Well Contractor

STATE WELL REPORT			
County:_Leflore	Part 2 Pump Installer's Completion Report	For Office Use Only:	
Permit #: 601 10544	Mississippi Department of Environmental Quality Office of Land and Water Resources	Aquifer:	
Irrigation Equipment	P.O. Box 10631 Jackson, MS 39289-0631	Well #: <u>F-170</u>	
Date completed:7-19-05	(601)961-5210 (601)354-6938 (fax)	Elevation:	

ي يو من يو ما

,

This report should be prepared by the pump installer in detail and filed with the Department within 30 days of the installation of pump.

Well Owner Information	Well Location		
Owner Name: Prestidge Farms	Latitude:Longitude:		
Mailing Address: 37301 County Road 523	Method of Lat/Long (circle one): Conventional Survey,		
	USGS quad, Hand-held GPS, Survey-grade GPS		
Schlater, MS 38952	14 14 Sec 2 Twn 20N Rng 2W		
City State Zip Code	Distance Direction Nearest Town		
662-254-6408	<u>1 Miles SW of Schlater</u>		

	Pump Typ Circle one			Power Circle	
Air Lift	Jet	Submersible	Diesel Engine	Gasoline En	ngine Natural Gas
Bucket	Piston	Turbine	Electric Motor	Hand	Tractor PTO
Centrifugal	Rotary	Flowing Well	Windmill	Other (spec	ify):
Other (specify):			Horse Power Ratin	ig of Motor:	60HP
Date Pump Installed			Setting Depth:	60	feet
Rated Pump Capaci	2500-3000 ty:) Gallons Per Minute	Number of Stages:	1	

		Method of Measuring Water Circle one	Vater Level	
Date Well Tested:				
Static Water Level (A):	Feet Below Land Surface	Air Line	Electric Measuring Line	Steel Tape
Pumping Water Level (B):	Feet Below Land Surface	Other (spech	§y):	
Drawdown [(B) - (A)]:	Feet Below Land Surface	For flowing	well, measured shut in head:	feet
Test Pumping Rate:	Gallons Per Minute	Well yielded	GPM with a	drawdown of
Duration of Pump Test (minimum	n 4 hours):hours		feet afterf	ours of pumping

I HEREBY CERTIFY that the above statements are true to the best	of my knowledge,
Patrick M. Chism 0695	Patrice M China
Print Name of Pump Installer and License No. (if applicable)	Signature of Pump Installer
	RECEIVEL

AUG 0 4 2005 BY: OLWR