

County: Leflore
 Permit #: _____
 Driller: _____
 Date drilling completed: _____

State Well Report
Part 1 - Driller's Log

Mississippi Department of Environmental Quality
 Office of Land and Water Resources
 P.O. Box 10631
 Jackson, MS 39289-0631
 (601)961-5210
 (601)354-6938 (fax)

For Office Use Only:
 Aquifer: _____
 Well #: F-192
 L. S. Elevation: _____
 E-log #: F-192

State Law requires that this report be prepared by the license holder responsible for the work and filed with the Department at the above address within 30 days of completion of drilling of the well or borehole.

Information on Well Owner (Landowner if borehole is not for a water well)	Well or Borehole Location
Owner Name: <u>BO Prestage</u>	Latitude: <u>33° 33' 50" N</u> Longitude: <u>90° 24' 02" W</u>
Mailing Address: <u>Co. Rd 523</u>	Method of Lat/Long (circle one): Conventional Survey, USGS quad, <u>Hand-held GPS</u> , Survey-grade GPS
<u>SEh.later MS 38952</u> City State Zip Code	<u>SW 1/4 SW 1/4 Sec 27 Twn 20N Rng 2W</u>
Telephone No. () _____	Distance <u>8</u> Miles Direction <u>W</u> of Nearest Town <u>Greenwood</u>

Well / Borehole Data

Date drilling started: 8/4/8 Date drilling completed: 8/5/8 Hole depth: 200 Hole diameter: 4.75

Location of the source of any surface water used for drilling: Creek By hole
 Method of dosing and volume of Chlorine used in drilling and development: Tap / 1000 gal

Logs run (circle all applicable): No log run Electric Gamma Ray Density Sonts Neutron Other: _____
 Name of organization running log(s): office of Geology

Purpose of borehole (check one): Water Well Geotechnical/Geological Investigation Ground Source Heat Pump
 Seismic Survey Other (describe) _____

If drilling is not related to water well construction, skip the remainder of this block

Purpose of Well (check one): Home Industrial Public Supply Irrigation Fish Culture Other: _____

If a flowing well, method of flow regulation: Valve _____ Other (describe) _____

Static Water Level: _____ feet above or below (circle one) land surface Date measured: _____

Method of Measurement (circle one) steel tape electric tape air line other: _____

Well depth: _____ Well grouted to a depth of _____ feet Type of grout (circle one): Neat Cement Bentonite Mix

Casing length: _____ feet Casing diameter: _____ inches Type of casing: _____

Screen length: _____ feet Screen diameter: _____ inches Type of screen: _____

Screen slot size: _____ inches Setting depth: From _____ feet to _____ feet

Type of completion (circle all applicable): Gravel packed Underreamed Telescoped Open hole Natural Development
 Other (describe): _____


Top of lap pipe or reduction in casing: _____ feet. *If telescoped or more than one screen, describe on next page*


Form: OLWR-SWR-1A

RECEIVED
 AUG 22 2008
 BY: OLWR

The sketch below only required for water wells

If well telescopes, show depths on sketch.

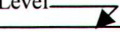Ground Level 

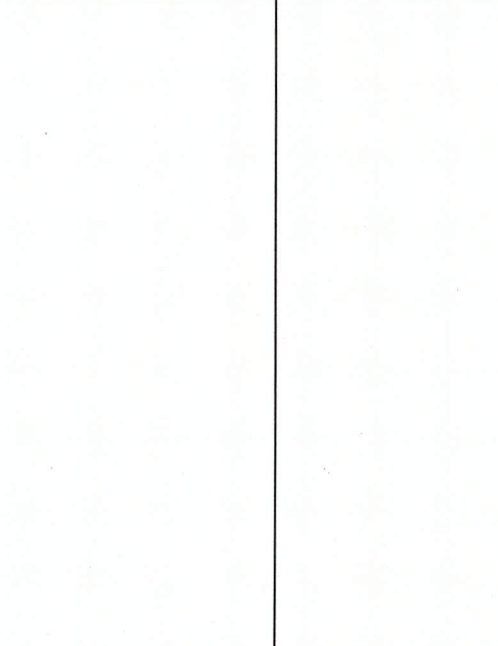


Description of formations encountered must be provided for all wells and boreholes, unless specifically exempted by regulations

Description of Formations Encountered	From (depth)	To (depth)
Clay	Ground Level	30
Sand	30	60
Sand & Gravel	60	100
Sand	100	145
Clay	145	150
Sand	150	180
Clay	180	200

If more than one screen, show location of each on sketch

Sketch the property layout and include the following: 1) the well location; 2) any permanent structures on the property that may aid in locating the well; 3) any roads, power lines, or other items that may aid in locating the property and the well; 4) a north arrow.

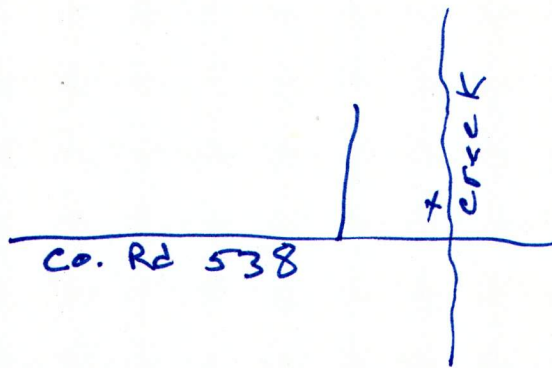

Landowner Name: _____

Form: OLWR-SWR-1A

I certify that the well/borehole was drilled, constructed, and completed in accordance with all applicable requirements of the Mississippi Department of Environmental Quality and the Mississippi Department of Health regulations, if applicable, and state laws.

Cletus Magee 0-619 8/15/08 Cletus Magee

Print Name of Responsible Licensee and License No. Date Signature of Licensee

RECEIVED
AUG 22 2008
BY: OLWR