

MISSISSIPPI DEPARTMENT OF ENVIRONMENTAL QUALITY

Office of Land and Water Resources

P. O. Box 10631
Jackson, MS 39289-0631
WATER WELL DRILLERS LOG

COUNTY WELL LOCATED Leflore	
WELL NUMBER 1-2017	CODED
DATE WELL COMPLETED 7-26-95	

PERMIT NUMBER
NAME OF DRILLING FIRM Irrigation Equipment Indianola, MS

NAME & MAILING ADDRESS OF LANDOWNER Tackett Fish Farm		
Rt.1, Box 187		
Schlater, MS 38952		
WELL LOCATION:	SEC	TOWNSHIP
NW/SE	8	20N S 2W W
DISTANCE	DIRECTION	NEAREST TOWN
4 Miles	SW	of Schlater
OTHER LANDMARK		
WELL PURPOSE: Home, Irrigation, Municipal, Industrial, Fish Pond, etc. Fish Pond-South Well		

PUMP DATA		
PUMP TYPE (Circle One): Submersible, (Turbine) , Jet, Flowing Well, Other (Describe) _____		
POWER TYPE (Circle One): (Electric) Tractor, Diesel, Gasoline, Butane, Other (Describe) _____ H/P 60		
Pump Capacity (GPM)	No. of Stages	Setting Depth
3000	1	70 FT.
PUMP TEST		
Well yielded _____ GPM with a drawdown of _____ ft. after _____ hours of pumping		

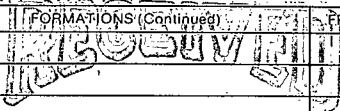
WELL DATA		
Well Depth 120	Casing Diameter (In.) 16	Casing Length (Ft.) 80
Type of Casing Steel	Hole Depth 120	Depth to Static Water Level 45 ft.
TYPE OF COMPLETION: (Circle One or More): (Gravel Packed) , Underreamed, Telescoped, Natural Development, Open Hole, Other (Describe) _____		
WELL GROUTED TO A DEPTH OF _____ FEET Type Grout (circle one): Cement, Bentonite, or Mix		

LOG DATA	
TYPE OF LOG RUN (Circle One): Electric, Gamma Ray, Density, Sonic, Neutron, Other (Describe) _____	
Name of Organization Running Log	

SCREEN DATA		
Diameter - Inches 16	Length - Feet 40	Slot Size - Inches .060
Screen Type Steel	Depth to Bottom - Feet 120	

GEOLOGIC DATA (Office Use Only)			
Surface Elev.	Geologic Unit	Unit Thickness	Depth to Top
Subs. SWL	Date	Analysis	Aquifer Test
Driller's Remarks			
Top of Lap Pipe or Reduction in Casing			
FEET		IF TELESCOPED OR MORE THAN ONE SCREEN: USE BACK PAGE	

DESCRIPTION OF FORMATIONS ENCOUNTERED	FROM	TO
Clay	0	40
Fine Sand & Gravel	40	75
Med. Sand & Gravel	75	120

FORMATIONS (Continued)		FROM	TO
			
SEP 25 1995			
Dept. of Environmental Quality Office of Land & Water Resources			
IF MORE SPACE IS NEEDED, USE BACK			

