

MISSISSIPPI DEPARTMENT OF ENVIRONMENTAL QUALITY

Office of Land and Water Resources

P. O. Box 10631
Jackson, MS 39289-0631
WATER WELL DRILLERS LOG

COUNTY WELL LOCATED	
LEFLORE	
WELL NUMBER	CODED
2	
DATE WELL COMPLETED	
9/20/95	

PERMIT NUMBER
NAME OF DRILLING FIRM
LAYNE-CENTRAL

NAME & MAILING ADDRESS OF LANDOWNER			
TACKETT FISH FARMS			
ROUTE 1, BOX 187			
SCHLATER, MS 38952			
WELL LOCATION:	SEC	TOWNSHIP	RANGE
	32	20N	N S 2W E W
DISTANCE	DIRECTION	NEAREST TOWN	
8 Miles	NW	ITTA BENA	
OTHER LANDMARK			
WELL PURPOSE: Home, Irrigation, Municipal, Industrial, Fish Pond, etc.			
IRRIGATION			

PUMP DATA		
PUMP TYPE (Circle One):		
Submersible,	Turbine,	Jet
Other (Describe) <u>TURBINE</u> Flowing Well,		
POWER TYPE (Circle One):		
Electric,	Tractor,	Diesel,
Other (Describe) <u>ELECTRIC</u> Gasoline, Butane, H/P		
Pump Capacity (GPM)	No. of Stages	Setting Depth
	1	75' FT.
PUMP TEST		
Well yielded _____ GPM with		
a drawdown of _____ ft.		
after _____ hours of pumping		

WELL DATA		
Well Depth	Casing Diameter (In.)	Casing Length (Ft.)
137'	16"	77'
Type of Casing	Hole Depth	Depth to Static Water Level
PVC	140'	32'
TYPE OF COMPLETION: (Circle One or More):		
Gravel Packed, Underreamed, Telescoped,		
Natural Development, Open Hole, Other		
(Describe) <u>GRAVEL PACKED</u>		
WELL GROUTED TO A DEPTH OF <u>10</u> FEET		
Type Grout (circle one): Cement, Bentonite, or Mix		

LOG DATA	
TYPE OF LOG RUN (Circle One):	
No Log Run, Electric, Gamma Ray, Density, Sonic, Neutron, Other (Describe)	
Name of Organization Running Log	

SCREEN DATA		
Diameter - Inches	Length - Feet	Slot Size - Inches
16"	60'	.050
Screen Type	Depth to Bottom - Feet	
PVC	137'	

GEOLOGIC DATA (Office Use Only)			
Surface Elev.	Geologic Unit	Unit Thickness	Depth to Top
Subs. SWL	Date	Analysis	Aquifer Test


Driller's Remarks
Top of Lap _____
RECEIVED
OCT 12 1995
Dept. of Environmental Quality Office of Land & Water Resources

DESCRIPTION OF FORMATIONS ENCOUNTERED	FROM	TO	FORMATIONS (Continued)	FROM	TO
CLAY	0	42			
SAND	42	46			
CLAY	46	50			
GRAVEL SAND	50	97			
ROCK	97	98			
GRAVEL SAND	98	140			
CLAY	140				

IF MORE SPACE IS NEEDED, USE BACK

If well telescopes please
sketch and show depths.

GROUND LEVEL

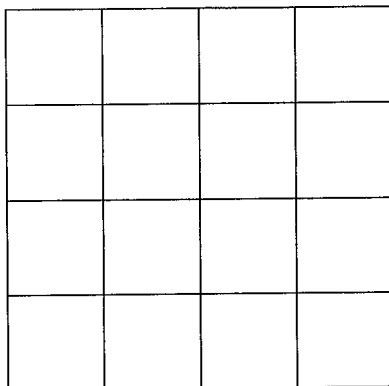

SECTION _____

Please indicate well location X.

ADDITIONAL INFORMATION

If more than one screen,
show location of each on sketch.