

MISSISSIPPI DEPARTMENT OF ENVIRONMENTAL QUALITY

Office of Land and Water Resources

P. O. Box 10631
Jackson, MS 39289-0631
WATER WELL DRILLERS LOG

COUNTY WELL LOCATED	
Teflore	
WELL NUMBER	CODED
F 2024	
DATE WELL COMPLETED	
7-9-96	

PERMIT NUMBER
NAME OF DRILLING FIRM
Irrigation Equipment
Indianola, MS 38751

NAME & MAILING ADDRESS OF LANDOWNER			
Conway Farms			
7600 CR350			
Greenwood, MS 38930			
WELL LOCATION:	SEC	TOWNSHIP	RANGE
	18	20N	2E
DISTANCE	DIRECTION	NEAREST TOWN	
7 Miles	NE	of Greenwood	
OTHER LANDMARK			
WELL PURPOSE: Home, Irrigation, Municipal, Industrial, Fish Pond, etc.			
Irrigation Pivot			

PUMP DATA			
PUMP TYPE (Circle One):			
Submersible,	<u>Turbine</u>	Jet	Flowing Well,
Other (Describe) _____			
POWER TYPE (Circle One):			
Electric, Tractor,	<u>Diesel</u>	Gasoline,	Butane,
Other (Describe) _____ H/P <u>200</u>			
Pump Capacity (GPM)	No. of Stages	Setting Depth	
2300	2	60 FT.	
PUMP TEST			
Well yielded _____ GPM with			
a drawdown of _____ ft.			
after _____ hours of pumping			

WELL DATA		
Well Depth	Casing Diameter (In.)	Casing Length (Ft.)
90	16	50
Type of Casing	Hole Depth	Depth to Static Water Level
Steel	90	20 ft. est.
TYPE OF COMPLETION: (Circle One or More):		
<u>Gravel Packed</u> , Underreamed, Telescoped,		
Natural Development, Open Hole, Other		
(Describe) _____		

LOG DATA	
TYPE OF LOG RUN (Circle One):	
Electric, Gamma Ray, Density, Sonic, Neutron,	No Log Run,
Other (Describe) _____	
Name of Organization Running Log	

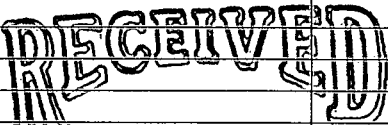
WELL GROUTED TO A DEPTH OF _____ FEET
Type Grout (circle one): Cement, Bentonite, or Mix

GEOLOGIC DATA (Office Use Only)			
Surface Elev.	Geologic Unit	Unit Thickness	Depth to Top
Subs. SWL	Date	Analysis	Aquifer Test

SCREEN DATA		
Diameter - Inches	Length - Feet	Slot Size - Inches
16	40	.060
Screen Type	Depth to Bottom - Feet	
Steel	90	

Driller's Remarks	
Top of Lap Pipe or Reduction in Casing	
FEET	IF TELESKOPED OR MORE THAN ONE SCREEN: USE BACK PAGE

DESCRIPTION OF FORMATIONS ENCOUNTERED	FROM	TO
Clay	0	10
Fine sand	10	18
Fine Sand & Gravel	18	35
Med. Sand & Gravel	35	90

FORMATIONS (Continued)	FROM	TO
 SEP 18 1996 Dept. of Environmental Quality Office of Land & Water Resources		

IF MORE SPACE IS NEEDED, USE BACK

If well telescopes please
sketch and show depths.

GROUND LEVEL

		X	

SECTION 18

Please indicate well location X.

ADDITIONAL INFORMATION

If more than one screen,
show location of each on sketch.