

**MISSISSIPPI DEPARTMENT OF ENVIRONMENTAL  
QUALITY**

Office of Land and Water Resources

P. O. Box 10631  
Jackson, MS 39289-0631

**WATER WELL DRILLERS LOG**

COUNTY WELL LOCATED Leflore	
WELL NUMBER <b>F 2026</b>	CODED
DATE WELL COMPLETED 8-20-96	

PERMIT NUMBER
NAME OF DRILLING FIRM Irrigation Equipment
Indianola, MS 38751

NAME & MAILING ADDRESS OF LANDOWNER			
Tackett Fish Farms			
Rt.1, Box 187			
Schlater, MS 38952			
WELL LOCATION:	SEC	TOWNSHIP	RANGE
	33	20N N S	2W E W
DISTANCE	DIRECTION		NEAREST TOWN
6 Miles	NW		Itta Bena
OTHER LANDMARK			
WELL PURPOSE: Home, Irrigation, Municipal, Industrial, Fish Pond, etc. Fish Pond			

<b>PUMP DATA</b>		
PUMP TYPE (Circle One): Submersible, <u>Turbine</u> , Jet, Flowing Well, Other (Describe) _____		
POWER TYPE (Circle One): <u>Electric</u> , Tractor, Diesel, Gasoline, Butane, Other (Describe) _____ H/P <u>60</u>		
Pump Capacity (GPM)	No. of Stages	Setting Depth
3000	1	70 FT.
PUMP TEST		
Well yielded _____ GPM with a drawdown of _____ ft. after _____ hours of pumping		

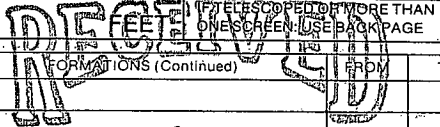
<b>WELL DATA</b>		
Well Depth 127	Casing Diameter (In.) 16	Casing Length (Ft.) 77
Type of Casing PVC	Hole Depth 127	Depth to Static Water Level 48 ft.
TYPE OF COMPLETION: (Circle One or More): <u>Gravel Packed</u> , Underreamed, Telescoped, Natural Development, Open Hole, Other (Describe) _____		

<b>LOG DATA</b>	
TYPE OF LOG RUN (Circle One): No Log Run, Electric, Gamma Ray, Density, Sonic, Neutron, Other (Describe) _____	
Name of Organization Running Log	

WELL GROUTED TO A DEPTH OF _____ FEET
Type Grout (circle one): Cement, Bentonite, or Mix

<b>GEOLOGIC DATA (Office Use Only)</b>			
Surface Elev.	Geologic Unit	Unit Thickness	Depth to Top
Subs. SWL	Date	Analysis	Aquifer Test

<b>SCREEN DATA</b>		
Diameter - Inches 16	Length - Feet 50	Slot Size - Inches .050
Screen Type PVC	Depth to Bottom - Feet 127	

Driller's Remarks
Top of Lap Pipe or Reduction in Casing


DESCRIPTION OF FORMATIONS ENCOUNTERED	FROM	TO
Clay	0	28
Fine sand	28	35
Fine Sand & Gravel	35	49
Med. Sand	49	85
Fine Sand & Gravel	85	98
Med. Sand & Gravel	98	127

FORMATIONS (Continued)	FROM	TO

NOV 06 1996  
Dept. of Environmental Quality  
Office of Land & Water Resources

IF MORE SPACE IS NEEDED, USE BACK

If well telescopes please  
sketch and show depths.

GROUND LEVEL

	X		

SECTION 33

Please indicate well location X.

ADDITIONAL INFORMATION

If more than one screen,  
show location of each on sketch.