

MISSISSIPPI DEPARTMENT OF ENVIRONMENTAL QUALITY

Office of Land and Water Resources

COUNTY WELL LOCATED Leflore	
WELL NUMBER F2032	CODED
DATE WELL COMPLETED 8-13-99	

PERMIT NUMBER
NAME OF DRILLING FIRM Irrigation Equipment Inc.
Indianola, MS

P. O. Box 10631
Jackson, MS 39289-0631
WATER WELL DRILLERS LOG

NAME & MAILING ADDRESS OF LANDOWNER Steve Peters		
1508 Brookstone Drive		
Graniteville, SC 29829		
WELL LOCATION	SEC	TOWNSHIP RANGE
	7	20N N 2W E S
DISTANCE	DIRECTION	NEAREST TOWN.
7 Miles	SW	Schlater
OTHER LANDMARK		
WELL PURPOSE: Home, Irrigation, Municipal, Industrial, Fish Pond, etc. Fish Pond		

PUMP DATA		
PUMP TYPE (Circle One): Submersible, <u>Turbine</u> Jet Flowing Well, Other (Describe)		
POWER TYPE (Circle One): <u>Electric</u> Tractor, Diesel, Gasoline, Butane, Other (Describe) H/P 60		
Pump Capacity (GPM) 2500	No. of Stages 2	Setting Depth 90 FT.
PUMP TEST		
Well yielded _____ GPM with a drawdown of _____ ft. after _____ hours of pumping.		

WELL DATA		
Well Depth 117	Casing Diameter (In.) 16	Casing Length (Ft.) 77
Type of Casing PVC	Hole Depth 117	Depth to Static Water Level 50ft.
TYPE OF COMPLETION: (Circle One or More): <u>Gravel Packed</u> Underreamed, Telescoped, Natural Development, Open Hole, Other (Describe)		

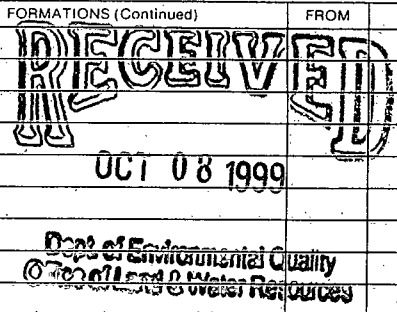
LOG DATA	
TYPE OF LOG RUN (Circle One): Electric, Gamma Ray, Density, Sonic, Neutron, Other (Describe) _____	
Name of Organization Running Log.	

WELL GROUTED TO A DEPTH OF _____ FEET Type Grout (circle one): Cement, Bentonite, or Mix

GEOLOGIC DATA (Office Use Only)			
Surface Elev.	Geologic Unit	Unit Thickness	Depth to Top
Subs. SWL	Date	Analysis	Aquifer Test.

SCREEN DATA		
Diameter - Inches 16	Length - Feet 40	Slot Size - Inches .050
Screen Type PVC	Depth to Bottom - Feet 117	

Driller's Remarks

DESCRIPTION OF FORMATIONS ENCOUNTERED	FROM	TO	FORMATIONS (Continued)	FROM	TO
Clay	0	28			
Fine Sand	28	41			
Fine Sand & Gravel	41	46			
Med. Sand & Gravel	46	114			
Clay	114	117			

IF MORE SPACE IS NEEDED, USE BACK

