

MISSISSIPPI DEPARTMENT OF NATURAL RESOURCES

Bureau of Land and Water Resources

Southport Mall

P.O. Box 10631

Jackson, Mississippi 39209

**CODED**

**WATER WELL DRILLERS LOG**

**BUTANE GAS COMPANY**

**OF GREENWOOD**

*Leflore*  
county well located

LEFLORE  
G.  
2-6-84

2-6 1984  
date well completed

LANDOWNER:  
*Brown Farms*  
*Schlater Ms*  
(mailing address)

description of formations encountered	from	to
<i>Clay</i>	<i>0</i>	<i>15</i>
<i>sand</i>	<i>15</i>	<i>30</i>
<i>sand + gravel</i>	<i>30</i>	<i>105</i>

WELL LOCATION:  
sec. *4* T. *20* N. R. *1* E  
S W  
*1.5* miles *S* of *Schlater*  
(distance) (direction) (nearest town)

WELL PURPOSE: *Irrigation*  
(home, irrigation, municipal, industrial)

**CODED**

- WELL COMPLETION DATA:
- (1) diameter (inches) *16"*
  - (2) total depth (feet) *105'*
  - (3) static water level (feet) *33* (below above top of ground)
  - (4) casing *Steel*, *65'*  
(material) (depth)  
*16"* if telescope see back.  
(size)
  - (5) screen *48'*, *65'*  
(length) (depth to top)  
*16"*, *Steel*  
(size) (material)
  - (6) pump *100* *1200*  
(HP) (yield gpm)  
*Diesel*  
(type power)
  - (7) electric log *No*  
(yes or no)  
*No*  
(organization running log)
  - (8) how well bottom plugged *Steel plate*


DRILLERS REMARKS:  
*Charles*

DEPT. OF NATURAL RESOURCES  
BUREAU OF LAND & WATER RESOURCES

FEB 21 1984  
**RECEIVED**

If well telescopes please sketch and show depths.

GROUND LEVEL

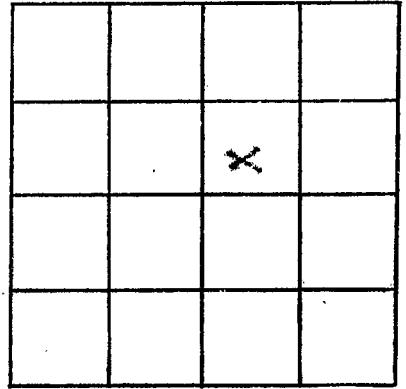

SECTION 4

Please indicate well location X.

ADDITIONAL INFORMATION

Lined area for additional information.

If more than one screen, show locations of each on sketch.