

Before MISSISSIPPI BOARD OF WATER COMMISSIONERS

G-7

2-15-66

WATER WELL DRILLERS LOG

**CODED**

Date: 2-15, 1966, Driller: Burtwood of LeFlore County LeFlore  
 (Name)

- (1) Owner of Land: L. W. WADE  
 (Name)  
GREENWOOD, MISS  
 (Address)
- (2) Location: 1/4, 1/4, Sec. 4 T9 R1E  
5 miles N.W., of LeWOOD  
 (distance) (direction) (Nearest Town)
- (3) Topography: FLAT  
 (Hilly) (Flat) (Level)
- (4) Purpose of Well: DOMESTIC  
 (Domestic Irrigation  
 Municipal, Industrial, Other)

Description & Color of Materials Sand, Clay, Red Clay, Shell, etc.	Thick- ness Feet	Depth Feet
1-25 CLAY	25	25
80 SAND	55	80
150 GRAVEL	70	150
280 SAND	130	280
340 SHALE	60	340
406 CLAY	76	416
550 GREEN SAND	134	550
600 SAND & SHALE	50	600
760 SHALE & CLAY	160	760
820 SET	60	820
900 SAND	80	900


Information upon completion of well:

- (1) Diameter 4x2 inches.
- (2) Total Depth 875 feet.
- (3) Water Level FLOW feet below top of ground.  
126" 4"
- (4) Cased to 749', Size 2"
- (5) Screen: Size 2", Length 20 FT
- (6) Were any formations sealed against pollution?  
no

BOTTOM OF WELL  
875'

**CODED**

If YES depth of formation \_\_\_\_\_  
 Why \_\_\_\_\_  
 Drillers Remarks: \_\_\_\_\_

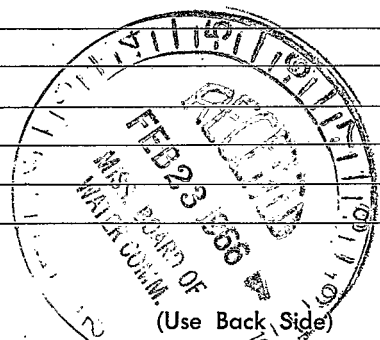

Yield in G. P. M.: 20

Type power: ELECTRIC

Crops irrigated & Acreages: NONE

Well No.

