

LEFLORE

68

2-8-74

MISSISSIPPI
 BOARD OF WATER COMMISSIONERS
 416 North State Street
 Jackson, Mississippi 39201

CODED

WATER WELL DRILLERS LOG

2-8 1974 DYER WELL & IRRIGATION SERVICE LEFLORE
 date well completed firm name county well located

LANDOWNER: RALE TRACK PLOT
GREENWOOD
MISS
 (mailing address)

description of fomations encountered	from	to
CLAY	0	22
FINE SAND	22	35
SAND PER ROCK	35	55
PER ROCK GRAVEL	55	98

WELL LOCATION:
 sec. 25 20 N R. 1 E
3 miles NW of Greenwood
 (distance) (direction) (nearest town)

WELL PURPOSE: DRP
 (home, irrigation, municipal, industrial)

- WELL COMPLETION DATA:
- (1) diameter (inches) 16"
 - (2) total depth (feet) 98'
 - (3) static water level (feet) 12' below above top of ground.
 - (4) casing Buck, 58'
 (material) (depth)
16"
 (size) If telescope see back.
 - (5) screen 40', 58'
 (length) (depth to top)
16", Buck
 (size) (material)
 - (6) pump 60 3000
 (HP) (yield gpm)
Diesel
 (type power)
 - (7) electric log No
 (yes or no)
 - (organization running log)
 - (8) how well bottom plugged Plugged

CODED


FEB 11 1974

MISS. Bd. OF WATER COMMISSIONERS

DRILLERS REMARKS:

If well telescopes please sketch and show depths.

GROUND LEVEL

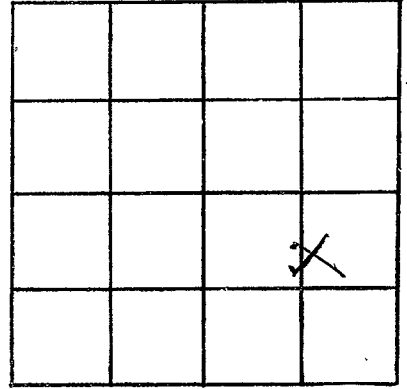

SECTION 25

Please indicate well location X.

ADDITIONAL INFORMATION

If more than one screen, show locations of each on sketch.