

LEFLORE
G10
1-10-74

MISSISSIPPI
BOARD OF WATER COMMISSIONERS
416 North State Street
Jackson, Mississippi 39201

CODED

WATER WELL DRILLERS LOG

1-10 date well completed 1974 24 DYER WELL & IRRIGATION SERVICE firm name LEFLORE county well located

LANDOWNER: PALETERRAC PT.
CROFTWOOD,
MISS.
(mailing address)

description of formations encountered	from	to
CLAY	0	20
FINE SAND	20	31
SAND PER ROCK	31	47
PER ROCK STRATUM	47	113

WELL LOCATION:
sec 20 T. 20 N R. 1 E
4 1/2 miles N.W. of G. WOOD
(distance) (direction) (nearest town)

WELL PURPOSE: FOR
(home, irrigation, municipal, industrial)

WELL COMPLETION DATA:

- (1) diameter (inches) 12"
- (2) total depth (feet) 113'
- (3) static water level (feet) 15' below above top of ground.
- (4) casing PVC, 73'
(material) (depth)
- 12" if telescope see back.
(size)
- (5) screen 40', 73'
(length) (depth to top)
- 16", BLK JIN 60T
(size) (material)
- (6) pump 300 2000
(HP) (yield gpm)
- DIESEL
(type power)
- (7) electric log NO
(yes or no)
- (organization running log)
- (8) how well bottom plugged PLATE


CODED

DRILLERS REMARKS:

FEB 1 1974

If well telescopes please sketch and show depths.

GROUND LEVEL

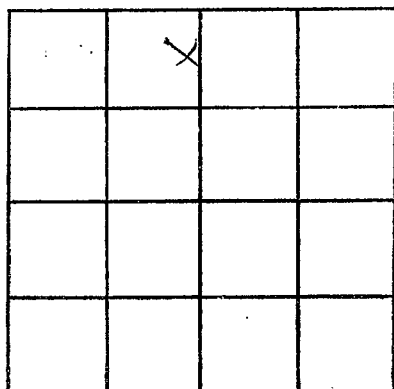

SECTION 26

Please indicate well location X.

ADDITIONAL INFORMATION

If more than one screen,
show locations of each on sketch.