

MISSISSIPPI BOARD OF WATER COMMISSIONERS

WATER WELL DRILLERS LOG

Leflore
615
6-66

Date: 6/18, 1966, Driller: Butane Gas Co. County Leflore
(Name)

(1) Owner of Land: Tom Gary
(Name)
Greenwood, Miss.
(Address)
(2) Location: NE 1/4, SW 1/4, Sec. 12, T1N, R1W
3 miles SW of MONEY
(distance) (direction) (Nearest Town)
(3) Topography: ✓
(Hilly) (Flat) (Level)
(4) Purpose of Well: Irrigation
(Domestic Irrigation, Municipal, Industrial, Other)

| Description & Color of Materials Sand, Clay, Red Clay, Shell, etc. | Thick- ness Feet | Depth Feet |
|---|------------------------|---------------|
| Clay | 13 | 13 |
| Brown Sand | 10 | 23 |
| Brown Sand | 10 | 33 |
| Brown Sand | 10 | 43 |
| Coarse Sand | 10 | 53 |
| Coarse Sand, Gravel | 10 | 63 |
| Coarse Sand, Gravel | 10 | 73 |
| Coarse Sand, Gravel | 10 | 83 |
| Coarse Sand, Gravel | 10 | 93 |
| Coarse Sand, Gravel | 10 | 103 |

Information upon completion of well:


(1) Diameter 12 inches.
(2) Total Depth 103 feet.
(3) Water Level 21 feet below top of ground.
(4) Cased to 63, Size 12
(5) Screen: Size 12, Length 40
(6) Were any formations sealed against pollution?
no

If YES depth of formation _____
Why _____

Drillers Remarks: _____

CODED

CODE

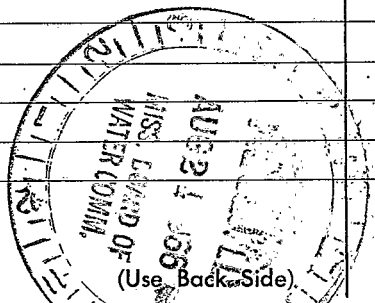

Well No.

100