

**MISSISSIPPI
BOARD OF WATER COMMISSIONERS
416 North State Street
Jackson, Mississippi 39201**

WATER WELL DRILLERS LOG

Leflore
613
12-66

date well completed 12-20-66 firm name Butane Gas Co. of Greenwood county well located Leflore

LANDOWNER: T. G. GARY
wildwood Plantation
Greenwood
(mailing address)

WELL LOCATION:
sec. 12 T. 20 N. R. 1 E. S. 5 W. W
2 1/2 miles SW of Money
(distance) (direction) (nearest town)

WELL PURPOSE: Home
(home, irrigation, municipal, industrial)

WELL COMPLETION DATA:

(1) diameter (inches) 4 3/4"
(2) total depth (feet) 1020
(3) static water level (feet) 10 ^{below}/_{above} top of ground.

(4) casing Steel, 987,
(material) (depth)
4 x 2 1/2 if telescope see back.
(size)

(5) screen 30', 987
(length) (depth to top)
2", Stainless Steel
(size) (material)

(6) pump 2, 45
(HP) (yield gpm)
Elec.
(type power)


(7) electric log NO
(yes or no)

(organization running log)

(8) how well bottom plugged BRASS
BACK WASH VALVE

description of formations encountered	from	to
CLAY	1	10
SAND + GRAVEL	10	120
SAND + SHALE	120	300
CLAY	300	400
SAND + CLAY	400	470
SAND + SHALE	470	630
SAND, SHALE + CLAY	630	760
SAND + SHALE	760	800
SHALE	800	980
HARD ROCK	980	981
WHITE SAND	981	1020

CODED

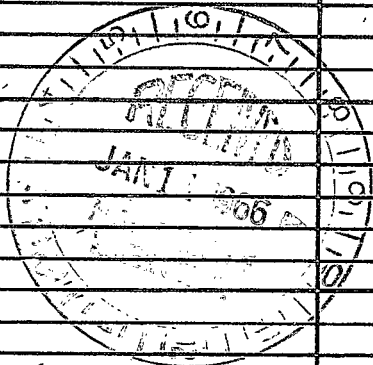

DRILLERS REMARKS:

If well telescopes please sketch and show depths.

GROUND LEVEL

105'
4" CASING

882'
2 1/2" CASING

30'
2" SCREEN

		X	

SECTION 12

Please indicate well location X.

ADDITIONAL INFORMATION

If more than one screen, show locations of each on sketch.