

LeFlore
 G19
 4-67

MISSISSIPPI
 BOARD OF WATER COMMISSIONERS
 416 North State Street
 Jackson, Mississippi 39201

WATER WELL DRILLERS LOG

4/5/67 19 Botane Gas of Greenwood LeFlore
 date well completed firm name county well located

LANDOWNER: L.W. WADE
Loggins Place
Box Greenwood, Miss
 (mailing address)


description of formations encountered	from	to
<u>Top Soil</u>	<u>0</u>	<u>40</u>
<u>FINE SAND</u>	<u>40</u>	<u>50</u>
<u>Med to Coarse Sand</u>	<u>50</u>	<u>100</u>
<u>& Gravel</u>		

WELL LOCATION:
 sec. 25 T 20 N R 1 E
3 miles N.W. of Greenwood
 (distance) (direction) (nearest town)

WELL PURPOSE: IRRIGATION
 (home, irrigation, municipal, industrial)

- WELL COMPLETION DATA:
- (1) diameter (inches) 12"
 - (2) total depth (feet) 100'
 - (3) static water level (feet) 25' below above top of ground.
 - (4) casing Black, 60',
 (material) (depth)
12 if telescope see back.
 (size)
 - (5) screen 40', 60'
 (length) (depth to top)
12", Black
 (size) (material)
 - (6) pump 70 2000
 (HP) (yield gpm)
L.P.G.
 (type power)
 - (7) electric log No
 (yes or no)
 (organization running log)
 - (8) how well bottom plugged STEEL PLATE


CODED

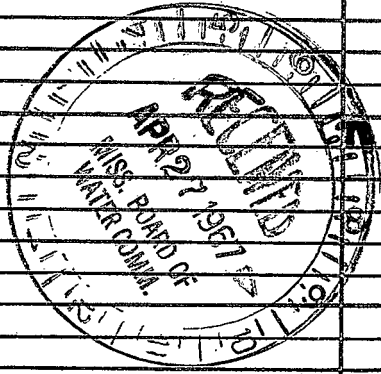

DRILLERS REMARKS:

If well telescopes please sketch and show depths.

GROUND LEVEL

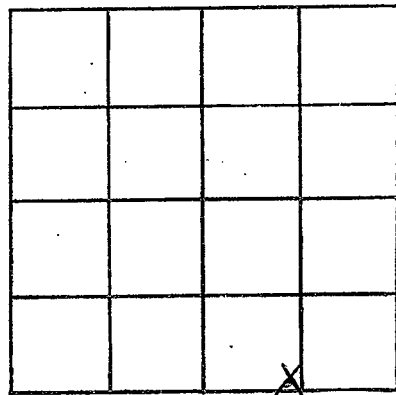

SECTION 25

Please indicate well location X.

ADDITIONAL INFORMATION

If more than one screen, show locations of each on sketch.