

GW 3873

*Leflore*  
~~GW 20~~  
 6-67  
 GW03873


MISSISSIPPI  
 BOARD OF WATER COMMISSIONERS  
 416 North State Street  
 Jackson, Mississippi 39201

WATER WELL DRILLERS LOG

*June 7, 1967* date well completed      *Botane Gas of Greenwood* firm name      *Leflore* county well located


LANDOWNER: <i>LAKE HENRY PLANT</i>	description of formations encountered	from	to
<i>L. W. WLADE</i>	<i>Top Soil</i>	<i>0</i>	<i>15</i>
<i>Box 1136 - GREENWOOD, Miss</i> (mailing address)	<i>Brown Clay</i>	<i>15</i>	<i>25</i>
WELL LOCATION: sec. <i>31</i> T. <i>20</i> N. R. <i>1</i> E	<i>Blue Clay</i>	<i>25</i>	<i>30</i>
<i>3</i> miles <i>N</i> of <i>ITABENA</i>	<i>Sand</i>	<i>30</i>	<i>50</i>
(distance) (direction) (nearest town)	<i>Coarse Sand &amp; Gravel</i>	<i>50</i>	<i>102</i>
WELL PURPOSE: <i>IRRIGATION</i> (home, irrigation, municipal, industrial)			
WELL COMPLETION DATA:			
(1) diameter (inches) <i>6"</i>			
(2) total depth (feet) <i>101'</i>			
(3) static water level (feet) <i>16</i> below top of ground			
(4) casing <i>STEEL</i> , <i>61'</i> (material), (depth) <i>6"</i> (size) if telescope see back.			
(5) screen <i>40'</i> , <i>61'</i> (length), (depth to top) <i>6"</i> , <i>STEEL</i> (size), (material)			
(6) pump <i>15</i> , <i>1000</i> (HP), (yield gpm) <i>L.P.C.</i> (type power)			
(7) electric log <i>No</i> (yes or no)  (organization running log)			
(8) how well bottom plugged <i>STEEL PLATE</i>			
DRILLERS REMARKS:			

CODED

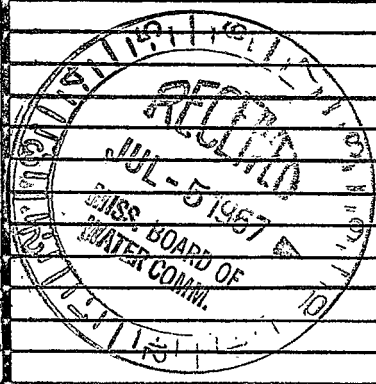

If well telescopes please sketch and show depths.

GROUND LEVEL

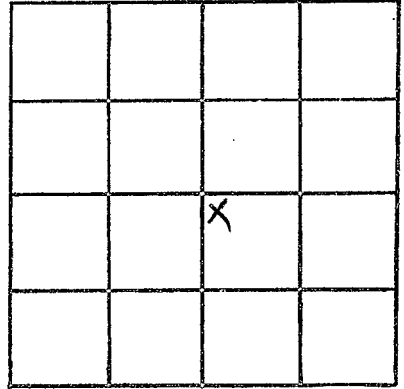

SECTION 31

Please indicate well location X.

ADDITIONAL INFORMATION

If more than one screen, show locations of each on sketch.