

MISSISSIPPI
BOARD OF WATER COMMISSIONERS
416 North State Street
Jackson, Mississippi 39201

CODED

WATER WELL DRILLERS LOG

LEFLORE
G 21
3-6-75

March 6, 1975 date well completed Dyer-Sullivan firm name Leflore county well located

LANDOWNER: Jimmy Green

description of formations encountered

from to

ITA BENA, Miss.

CLAY	0	33
FINE SAND	33	73
SAND & GRAVEL	73	113

(mailing address)

WELL LOCATION:

sec. 33 T. 20 N. R. 2 E
S. 4 W
4 1/2 miles N of ITA BENA
(distance) (direction) (nearest town)

WELL PURPOSE: Irrigation
(home, irrigation, municipal, industrial)


WELL COMPLETION DATA:

- (1) diameter (inches) 16"
- (2) total depth (feet) 113'
- (3) static water level (feet) 11 below above top of ground.
- (4) casing Blk Iron, 73',
(material) (depth)
16"
(size) if telescope see back.
- (5) screen 40', 73'
(length) (depth to top)
16"
(size) (material)
- (6) pump 40 2000
(HP) (yield gpm)
Diesel
(type power)
- (7) electric log No
(yes or no)

(organization running log)

(8) how well bottom plugged Date

CODED

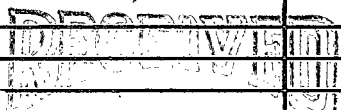


DEC 13 1975

DRILLERS REMARKS:

MISS. Bd. OF WATER COMMISSIONERS

If well telescopes please sketch and show depths.

GROUND LEVEL

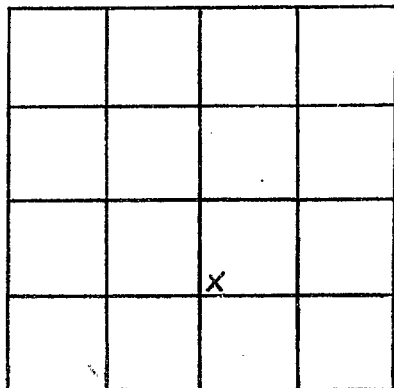

SECTION 33

Please indicate well location X.

ADDITIONAL INFORMATION

If more than one screen,
show locations of each on sketch.