

LEFLORE

G 22

9/20/74

MISSISSIPPI BOARD OF WATER COMMISSIONERS
416 North State Street
Jackson, Mississippi 39201

CODED

WATER WELL DRILLERS LOG

SEPT 20, 74

DRYER WELL & IRRIGATION SERVICE

LEFLORE

date well completed

firm name

county well located

LANDOWNER:

description of formations encountered

from

to

HOPSON GARY

CLAY

0

24

SCHWATER, MISS.

SAND + PEARL

24

39

(mailing address)

COARSE SAND PEA

39

ROCK, GRAVEL

113

WELL LOCATION:

sec. 22 T. 20 N R. 1 E
1 1/2 miles S.W. of SHELLMOUND
(distance) (direction) (nearest town)

WELL PURPOSE:

IRR (home, irrigation, municipal, industrial)

WELL COMPLETION DATA:

- (1) diameter (inches) 16"
- (2) total depth (feet) 113'
- (3) static water level (feet) 19' below above top of ground.
- (4) casing RUCR (material), 73' (depth)
16" (size) if telescope see back.
- (5) screen 40 (length), 73' (depth to top)
16" (size), BLK IN 605 (material)
- (6) pump 60 (HP), 3000 (yield gpm)
ELEC. (type power)
- (7) electric log No (yes or no)

CODED

(organization running log)

(8) how well bottom plugged PLATE

DRILLERS REMARKS:


RECORDED
INDEXED

NOV 21 1974

MISS. BD. OF WATER COMM

If well telescopes please sketch and show depths.

GROUND LEVEL

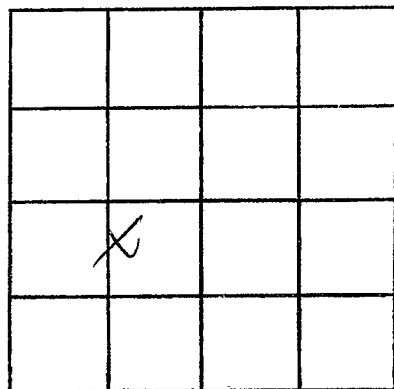

SECTION 22

Please indicate well location X.

ADDITIONAL INFORMATION

If more than one screen,
show locations of each on sketch.