

Leflore  
 B 24  
 3/17/78

MISSISSIPPI  
 BOARD OF WATER COMMISSIONERS  
 416 North State Street  
 Jackson, Mississippi 39201

CODED

WATER WELL DRILLERS LOG  
 BUTANE GAS COMPANY

Leflore

3-17-78  
 date well completed

OF GREENWOOD  
 farm name

county well located

LANDOWNER:  
 L. W. Wade  
 Greenwood  
 (mailing address)

description of formations encountered	from	to
Clay	0	10
SAND	10	20
SAND + Pea Gravel	20	60
SAND + GRAVEL	60	100

WELL LOCATION:  
 sec. 36 T 20 N R 1 E  
 S W  
 3 1/2 miles NW of Greenwood  
 (distance) (direction) (nearest town)

WELL PURPOSE: I.R.R.  
 (home, irrigation, municipal, industrial)

WELL COMPLETION DATA:

(1) diameter (inches) 16"

(2) total depth (feet) 100

(3) static water level (feet) 18 below top of ground.

(4) casing Steel, 60 (material) (depth)  
 16" (size) if telescope see back.

(5) screen 40, 60 (length) (depth to top)  
 16" (size) Steel (material)

(6) pump 50, 2500 (HP) (yield gpm)  
 Elec. (type power)

(7) electric log No (yes or no)

(organization running log)

(8) how well bottom plugged  
 Steel Plate

DRILLERS REMARKS:


RECEIVED

MAR 23 1978

MISSISSIPPI BOARD OF WATER COMMISSIONERS

If well telescopes please sketch and show depths.

GROUND LEVEL

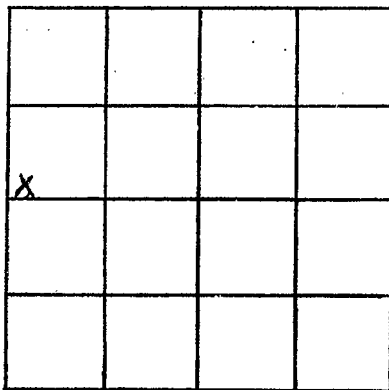

SECTION 36

Please indicate well location X.

ADDITIONAL INFORMATION

If more than one screen,  
show locations of each on sketch.